

MISSISSIPPI DEPARTMENT OF ENVIRONMENTAL QUALITY

Office of Land and Water Resources

COUNTY WELL LOCATED
PEAR-RIVER

WELL NUMBER **9** CODED

DATE WELL COMPLETED
6-29-92

PERMIT NUMBER
0-519

NAME OF DRILLING FIRM
WAS WALKER'S ATTORNEE WELL WAS DRILLERS

Jack Burye

P. O. Box 10631
Jackson, MS 39289-0631
WATER WELL DRILLERS LOG

NAME & MAILING ADDRESS OF LANDOWNER
GEORGE HARRISON
+ ANN ? Lewis

WELL LOCATION: SEC _____ TOWNSHIP **? N ? E** RANGE **? W**

DISTANCE **12** Miles **SOUTH** of **PEARL RIVER**

OTHER LANDMARK _____

WELL PURPOSE: Domestic Irrigation, Municipal, Industrial, Fish Pond, etc.

PUMP DATA

PUMP TYPE (Circle One): Submersible, Turbine, Jet, Flowing Well, Other (Describe) _____

POWER TYPE (Circle One): Electric, Tractor, Diesel, Gasoline, Butane, Other (Describe) _____ H/P **34**

Pump Capacity (GPM) **15** No. of Stages **10** Setting Depth **80** FT.

PUMP TEST

Well yielded **15** GPM with a drawdown of _____ ft. after _____ hours of pumping

WELL DATA

Well Depth **110'** Casing Diameter (In.) **4** Casing Length (Ft.) **110'**

Type of Casing **PVC** Hole Depth **110'** Depth to Static Water Level **40'**

LOG DATA

TYPE OF LOG RUN (Circle One): No Log Run, Electric, Gamma Ray, Density, Sonic, Neutron, Other (Describe) _____

Name of Organization Running Log _____

TYPE OF COMPLETION: (Circle One or More): Gravel Packed, Underreamed, Telescoped, Natural Development, Open Hole, Other (Describe) _____

WELL GROUTED TO A DEPTH OF **8** FEET
Type Grout (circle one): Cement, Bentonite, or Mix

GEOLOGIC DATA (Office Use Only)

Surface Elev.	Geologic Unit	Unit Thickness	Depth to Top
Subs. SWL	Date	Analysis	Aquifer Test

SCREEN DATA

Diameter - Inches **4** Length - Feet **10'** Slot Size - Inches **#12**

Screen Type **SLOT** Depth to Bottom - Feet **110**

Driller's Remarks
WELL WAS NOT LOG BY MISPLACED RECEIPT'S
Jack Burye

Top of Lap Pipe or Reduction in Casing


FEET IF TELESCOPED OR MORE THAN ONE SCREEN: USE BACK PAGE

DESCRIPTION OF FORMATIONS ENCOUNTERED	FROM	TO
RED CLAY SAND	0	15
WHITE CLAY SAND	15	20
PEAT GRAVEL	20	40
	40	80
	80	110

FORMATIONS (Continued)	FROM	TO
RECEIVED		
DEC 14 1994		
Dept. of Environmental Quality Office of Land & Water Resources		
IF MORE SPACE IS NEEDED, USE BACK		

If well telescopes please sketch and show depths.

GROUND LEVEL

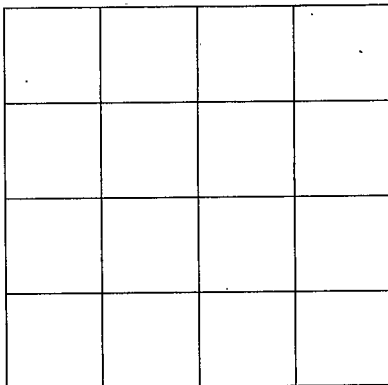

SECTION _____

Please indicate well location X.

ADDITIONAL INFORMATION

WELL WAS DRILLED 6-29-92
I COST THE BILL BOOK & DID
NOT LOG THIS WELL. AT
2 YEARS AND 3 MONTHS
I HEARD FROM ANN SAYING
THE WELL WAS NO GOOD
I WENT & BLOWED THE WELL
OUT & STOPPED SAND PROBLEM
THEN 2 WEEKS LATER TANK
WATER LOGGED SHE CALL
JONNY BIGGATT & TOLD HIM
I WHEN SAND & FIX WELL

SHE SAID SHE WOULD
CALL MR. JONNY & TELL
I TOOK CARE OF HER
WELL & SHE IS HAPPY

John Ben
THIS WELL MAY BE LOGGED
UNDER GEORGE HARRISON?
ALREADY

If more than one screen,
show location of each on sketch.