

Change our firm name to
 Carl B. Fenton Well Service

PEARL RIVER

RI

2-19-71

MISSISSIPPI
 BOARD OF WATER COMMISSIONERS
 416 North State Street
 Jackson, Mississippi 39201

CODED

WATER WELL DRILLERS LOG

2-19-71 E & J water well users. Pearl River
 date well completed firm name county well located

LANDOWNER:

Craig W. Gilbert

Rt. 2 Poplarville Miss.
 (mailing address)

description of formations encountered

white & red clay 0 18

Brown clay 18 40

Blue clay 40 75

fine blue sd. 75 84

Blue clay 84 176

Coarse gray sd. & fine gravel 176 194

WELL LOCATION:

sec. 33 T 4 N R 15 E

4 miles 50. of Searsville
 (distance) (direction) (nearest town)

WELL PURPOSE: Home
 (home, irrigation, municipal, industrial)

WELL COMPLETION DATA:

(1) diameter (inches) 4.5

(2) total depth (feet) 194

(3) static water level (feet) 102 below top of ground.

(4) casing Plastic 189
 (material) (depth)

2" If telescope see back.
 (size)

(5) screen 5 189-194
 (length) (depth to top)

2" Plastic
 (size) (material)

(6) pump 1 350 Hr.
 (HP) (yield gpm)

Elect.
 (type power)

(7) electric log NO
 (yes or no)

(organization running log)

(8) how well bottom plugged shoe

CODED


MAY 17 1971

MISS. BD. OF
 WATER COMMISSIONERS

DRILLERS REMARKS:

If well telescopes please sketch and show depths.

GROUND LEVEL

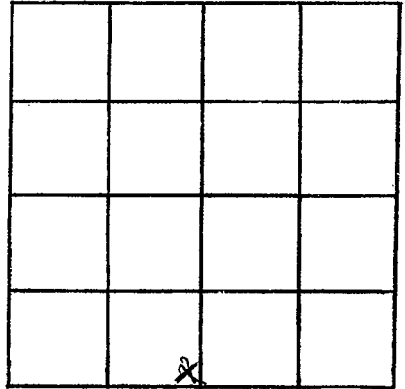

SECTION 33

Please indicate well location X.

ADDITIONAL INFORMATION

If more than one screen,
show locations of each on sketch.