

PEARL RIVER
R 2
3-26-71

MISSISSIPPI
BOARD OF WATER COMMISSIONERS
416 North State Street
Jackson, Mississippi 39201

CODED

WATER WELL DRILLERS LOG

3-26 1971 E & J water wellers Pearl River
date well completed firm name county well located

LANDOWNER:
Paul E. Carl Pepper
RT 3, Poplarville miss
(mailing address)

description of formations encountered	from	to
Brown med. sd.	0	6
Red clay	6	21
Coarse Red sd. & Gravel	21	58'

WELL LOCATION:
sec. 17 T 4 N R 15 E
5 miles East of Millard
(distance) (direction) (nearest town)

WELL PURPOSE: Home
(home, irrigation, municipal, industrial)

- WELL COMPLETION DATA:
- (1) diameter (inches) 7 1/2"
 - (2) total depth (feet) 58'
 - (3) static water level (feet) 26 below/above top of ground.
 - (4) casing Plastic 48' (material) (depth)
4" (size) if telescope see back.
 - (5) screen 10' 48-58 (length) (depth to top)
4" Plastic (size) (material)
 - (6) pump 1 840 (HP) (yield gpm)
Elect. (type power)
 - (7) electric log NO (yes or no)
(organization running log)
 - (8) how well bottom plugged Slor

CODED

MAY 17 1971

MISS. BD. OF
WATER COMMISSIONERS


MAY 17 1971

MISS. BD. OF
WATER COMMISSIONERS

DRILLERS REMARKS:

If well telescopes please sketch and show depths.

GROUND LEVEL

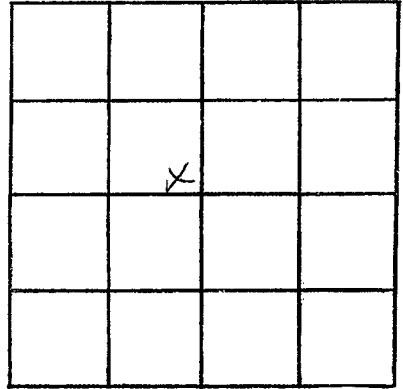

SECTION 17

Please indicate well location X.

ADDITIONAL INFORMATION

If more than one screen,
show locations of each on sketch.