

PEARL RIVER

R5

9-29-71

MISSISSIPPI
BOARD OF WATER COMMISSIONERS
416 North State Street
Jackson, Mississippi 39201

WATER WELL DRILLERS LOG

CODED

9-29

date well completed

19 71 Pantow well serv

firm name

Pearl River

county well located

LANDOWNER: FRANK Gordon

description of formations
encountered

from

to

Rt 2

Surface Clay

0

35

Carriere Miss

Blue clay

35

105

(mailing address)

sand

105

257

Blue clay

257

280

WELL LOCATION:

sand

280

312

sec. 30 T 4 N R 15 E

Blue clay

312

500

S

W

sand

500

556

6

miles East

of McNeil

(distance)

(direction)

(nearest town)

WELL PURPOSE:

(home, irrigation, municipal, industrial)

Home

WELL COMPLETION DATA:

(1) diameter (inches) 2

(2) total depth (feet) 556

(3) static water level (feet) 53 below
top of ground. above(4) casing Galv. 546
(material) (depth)2
(size) If telescope see back.(5) screen 10 546
(length) (depth to top)2 S. Steel
(size) (material)(6) pump 1 9
(HP) (yield gpm)Elec
(type power)(7) electric log NO
(yes or no)

(organization running log)

(8) how well bottom plugged BW Value

DRILLERS REMARKS:


CODED

NOV 9 - 1971

MISS. BD. OF
WATER COMM.

If well telescopes please
sketch and show depths.

GROUND LEVEL

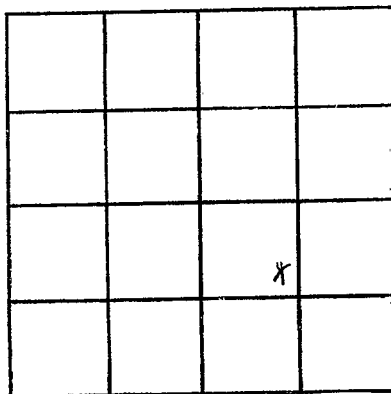

SECTION 30

Please indicate well location X.

ADDITIONAL INFORMATION

If more than one screen,
show locations of each on sketch.