

PEARL RIVER
R 6
5-6-72

MISSISSIPPI
 BOARD OF WATER COMMISSIONERS
 416 North State Street
 Jackson, Mississippi 39201

CODED

WATER WELL DRILLERS LOG

5-6 1972 Bud Parker & Son Pearl River
 date well completed firm name county well located

LANDOWNER: Aswell Eaton
McNeill, Miss.
 (mailing address)

description of formations encountered	from	to
<u>White Shale</u>	<u>0</u>	<u>12</u>
<u>White Sand</u>	<u>12</u>	<u>48</u>
<u>Sand</u>	<u>48</u>	<u>68</u>
<u>Blue Shale</u>	<u>68</u>	<u>220</u>
<u>Blue Sand</u>	<u>220</u>	<u>380</u>
<u>Blue Shale</u>	<u>380</u>	<u>525</u>
<u>Sand & Gravel</u>	<u>525</u>	<u>624</u>

WELL LOCATION:
 sec. 25 T. 4 N. R. 15 E. S. 2
2 miles E of McNeill
 (distance) (direction) (nearest town)

WELL PURPOSE: Fish & Pond
 (home, irrigation, municipal, industrial)

WELL COMPLETION DATA:

- (1) diameter (inches) 4 X 2
- (2) total depth (feet) 624
- (3) static water level (feet) 8 1/2 below top of ground.
- (4) casing Galv. 1004
 (material) (depth)
 (size) If telescope see back.
- (5) screen 20 ft. 604
 (length) (depth to top)
2 X 20 Stainless Steel
 (size) (material)
- (6) pump _____
 (HP) (yield gpm)
 (type power)
- (7) electric log _____
 (yes or no)
 (organization running log)
- (8) how well bottom plugged Bud Parker


CODED

DRILLERS REMARKS:
He furnished
own pump

APR 9 10 1972

If well telescopes please sketch and show depths.

GROUND LEVEL

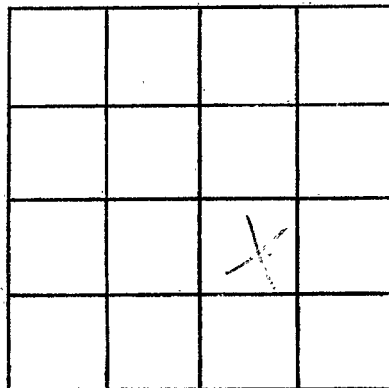

SECTION _____

Please indicate well location X.

ADDITIONAL INFORMATION

If more than one screen, show locations of each on sketch.