

PEARL RIVER  
R 7  
6-20-72

MISSISSIPPI  
BOARD OF WATER COMMISSIONERS  
416 North State Street  
Jackson, Mississippi 39201

**CODED**

WATER WELL DRILLERS LOG

6-20 1972 Bad Center, Pearl River  
date well completed firm name county well located


LANDOWNER:		description of formations encountered	from	to
<u>Mike Smith</u> <u>Carver, Miss.</u> (mailing address)				
		<u>Blue shale</u>	<u>6</u>	<u>12</u>
		<u>hard rock</u>	<u>72</u>	<u>230</u>
		<u>Blue shale</u>	<u>330</u>	<u>250</u>
WELL LOCATION:				
sec <u>247</u> T <u>4</u> N R <u>15</u> E <u>7</u> miles <u>E</u> of <u>McNolia</u> (distance) (direction) (nearest town)				
WELL PURPOSE:				
(home, irrigation, municipal, industrial)				
WELL COMPLETION DATA:				
(1) diameter (inches) <u>2 in</u>				
(2) total depth (feet) <u>253</u>				
(3) static water level (feet) <u>127</u> below above top of ground.				
(4) casing <u>Galv. 247</u> (material) (depth)				
(size) if telescope see back.				
(5) screen <u>5 ft. 247</u> (length) (depth to top)				
<u>2 1/2</u> (size) <u>8. Steel</u> (material)				
(6) pump <u>1</u> (HP) <u>270</u> (yield gpm)				
<u>electric</u> (type power)				
(7) electric log <u>No</u> (yes or no)				
(organization running log)				
(8) how well bottom plugged <u>hard shale</u>				
DRILLERS REMARKS:				

**CODED**

JUN 16 1972

If well telescopes please sketch and show depths.

GROUND LEVEL

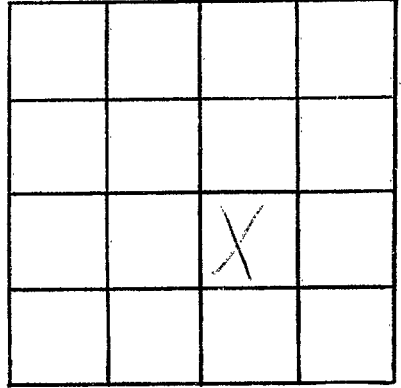

SECTION \_\_\_\_\_

Please indicate well location X.

ADDITIONAL INFORMATION

If more than one screen, show locations of each on sketch.