

LOCATION 7

MISSISSIPPI
BOARD OF WATER COMMISSIONERS
416 North State Street
Jackson, Mississippi 39201

WATER WELL DRILLERS LOG

PEARL RIVER
R8
6-2-72

6-2 1972 *Paul Center, Sr.* Pearl River
date well completed firm name county well located

LANDOWNER:
Scottie Duxton
Carriver, Miss.
(mailing address)

description of formations encountered	from	to
	<i>Red Shale</i>	<i>0</i>
<i>Blue Shale</i>	<i>43</i>	<i>180</i>
<i>Blue Sand & Rock</i>	<i>180</i>	<i>221</i>

WELL LOCATION:
sec *10* T *4* N R *15* E
10 miles *NE* of *Cowan*
(distance) (direction) (nearest town)

WELL PURPOSE: *Home*
(home, irrigation, municipal, industrial)

WELL COMPLETION DATA:

(1) diameter (inches) *2 in*

(2) total depth (feet) *221*

(3) static water level (feet) *13* ^{below}/_{above} top of ground.

(4) casing *Galv. 2 1/2"*
(material) (depth)

(size) if telescope see back.

(5) screen *10 ft. 2 1/2"*
(length) (depth to top)

2 x 1/2" *S. Steel*
(size) (material)

(6) pump *electric*
(HP) (yield gpm)
(type power)

(7) electric log *no*
(yes or no)

(organization running log)


(8) how well bottom plugged
Sand Shale

DRILLERS REMARKS:

111 10 476
1972

If well telescopes please sketch and show depths.

GROUND LEVEL

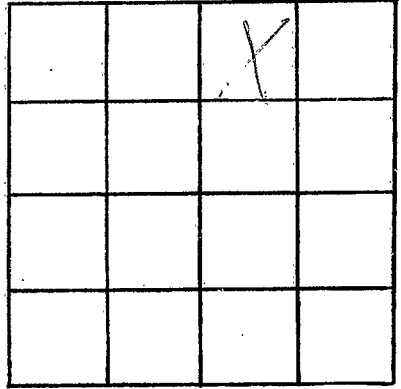

SECTION _____

Please indicate well location X.

ADDITIONAL INFORMATION

If more than one screen,
show locations of each on sketch.