

PEARL RIVER
R 9
9-2-72

MISSISSIPPI
BOARD OF WATER COMMISSIONERS
416 North State Street
Jackson, Mississippi 39201

WATER WELL DRILLERS LOG

CODED

9/2 date well completed 172 Bud Denton Pearl River firm name county well located

LANDOWNER: Jillie Smith
Rt. 2 Pearl River
Miss.
(mailing address)

description of formations encountered	from	to
<u>Red shale</u>	<u>0</u>	<u>8</u>
<u>Red sand</u>	<u>8</u>	<u>13</u>

WELL LOCATION:
sec. 11 T. 4 N. R. 15 E.
16 miles S of Pearl River
(distance) (direction) (nearest town)

WELL PURPOSE: home
(home, irrigation, municipal, industrial)

- WELL COMPLETION DATA:
- (1) diameter (inches) 4 in
 - (2) total depth (feet) 63
 - (3) static water level (feet) 22 below above top of ground.
 - (4) casing PVC 53
(material) (depth)
(size) if telescope see back.
 - (5) screen 4x10 53
(length) (depth to top)
4x10 PVC 4 1/2
(size) (material)
 - (6) pump 1/2 850
(HP) (yield gpm)
Elect.
(type power)
 - (7) electric log no
(yes or no)

CODED

(organization running log)

(8) how well bottom plugged hard shale


DRILLERS REMARKS:

SEP 21 1972

MISSISSIPPI
WATER BOARD

If well telescopes please sketch and show depths.

GROUND LEVEL

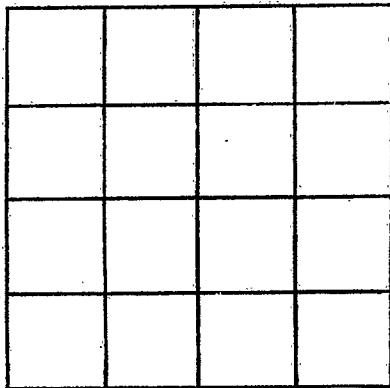

SECTION _____

Please indicate well location X.

ADDITIONAL INFORMATION

If more than one screen, show locations of each on sketch.