

Pearl River  
R 12  
4-9-70

MISSISSIPPI  
BOARD OF WATER COMMISSIONERS  
416 North State Street  
Jackson, Mississippi 39201

WATER WELL DRILLERS LOG

4-9 1970 *Penon Well Serv* Pearl River  
date well completed firm name county well located

LANDOWNER: *Bernell Smith*  
*Rt. 1*  
*Bush La.*  
(mailing address)

description of formations encountered	from	to
<i>Red sandy clay</i>	<i>0</i>	<i>65</i>
<i>Red sand</i>	<i>65</i>	<i>83</i>

WELL LOCATION:  
sec. *30* T *4* N R *15* S  
*5 1/2* miles *South* of *Savannah*  
(distance) (direction) (nearest town)

WELL PURPOSE: *Home*  
(home, irrigation, municipal, industrial)

- WELL COMPLETION DATA:
- (1) diameter (inches) *2*
  - (2) total depth (feet) *83*
  - (3) static water level (feet) *57* ~~above~~ below top of ground.
  - (4) casing *Galv* *78*  
(material) (depth)  
*2* if telescope see back.  
(size)
  - (5) screen *5'* *78*  
(length) (depth to top)  
*2* *3. steel*  
(size) (material)
  - (6) pump *1* *6*  
(HP) (yield gpm)  
*Elec*  
(type power)
  - (7) electric log *NO*  
(yes or no)

(organization running log)  
(8) how well bottom plugged *Blw Valve*


MAY 5 1970

DRILLERS REMARKS:

MISS. RD. OF  
WATER COMMISSIONERS

If well telescopes please sketch and show depths.

GROUND LEVEL

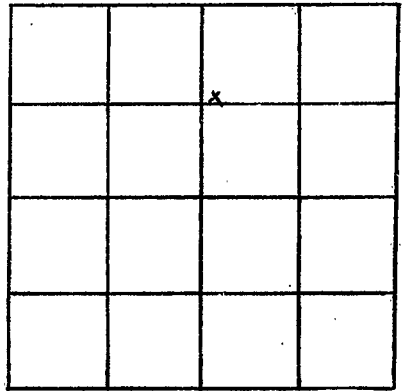

SECTION 30

Please indicate well location X.

ADDITIONAL INFORMATION

If more than one screen,  
show locations of each on sketch.