

PEARL RIVER

R 13

11-2-70

MISSISSIPPI BOARD OF WATER COMMISSIONERS 416 North State Street Jackson, Mississippi 39201

CODED

WATER WELL DRILLERS LOG

Nov-2 date well completed

1970 H. A. Poole firm name

PEARL RIVER county well located

LANDOWNER:

CLIFTON SMITH

RT#3, Poplarville Miss (mailing address)

description of formations encountered

from

to

Surface clay 0 15
SANDY CLAY 15 20
CLAY 20 75
SANDY CLAY 75 90
CUMBER SAND 90 105

WELL LOCATION:

sec 7 T 4 N R 15 E
9 miles S-E of Poplarville
(distance) (direction) (nearest town)

WELL PURPOSE: FARM HOUSE (home, irrigation, municipal, industrial)

WELL COMPLETION DATA:

- (1) diameter (inches) 6"
(2) total depth (feet) 105'
(3) static water level (feet) 60' below top of ground.
(4) casing PVC 95ft (material) (depth)
4" (size) if telescope see back.
(5) screen 10ft 95ft (length) (depth to top)
4" PVC (size) (material)
(6) pump 1 (HP) 24 (yield gpm)
Elec (type power)
(7) electric log No (yes or no)

CODED

(organization running log)

NOV 5 - 1970


(8) how well bottom plugged Back wash JAW

MISS. BD. OF WATER COMM.

DRILLERS REMARKS:

If well telescopes please sketch and show depths.

GROUND LEVEL

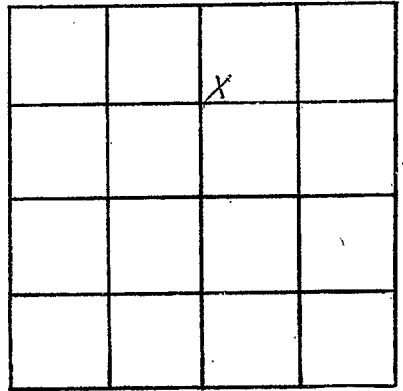

SECTION 7

Please indicate well location X.

ADDITIONAL INFORMATION

If more than one screen, show locations of each on sketch.