

PEARL RIVER
R 14
10-28-70

MISSISSIPPI
BOARD OF WATER COMMISSIONERS
416 North State Street
Jackson, Mississippi 39201

CODED

WATER WELL DRILLERS LOG

10-28 1970 Pontoni Well serv Pearl River
date well completed firm name county well located

LANDOWNER: Harry McHissack
Rt. 2
Carriere Miss
(mailing address)

description of formations encountered	from	to
Surface Clay	0	25
Sand	25	57
White Clay	57	95
Blue Clay	95	190
Grey Sand	190	216

WELL LOCATION:
sec. 27 T. 4 N. R. 15 E.
S W
7 miles East of McNeill
(distance) (direction) (nearest town)

WELL PURPOSE: Home
(home, irrigation, municipal, industrial)

- WELL COMPLETION DATA:
- (1) diameter (inches) 2
 - (2) total depth (feet) 216
 - (3) static water level (feet) 83 below top of ground.
 - (4) casing Galv. 211 (material) (depth)
2 (size) if telescope see back.
 - (5) screen 5 (length) 211 (depth to top)
 - (6) pump 1 (HP) 6 (yield gpm)
Elec (type power)
 - (7) electric log NO (yes or no)
 - (8) how well bottom plugged B.V. Valve

CODED


NOV 24 1970

DRILLERS REMARKS:

MISS. BD. OF
WATER COMMISSIONERS

If well telescopes please sketch and show depths.

GROUND LEVEL

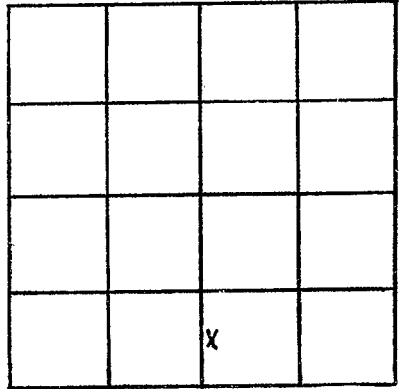

SECTION 29

Please indicate well location X.

ADDITIONAL INFORMATION

If more than one screen, show locations of each on sketch.