

PEARL RIVER

R15

11-5-70

MISSISSIPPI BOARD OF WATER COMMISSIONERS 416 North State Street Jackson, Mississippi 39201

CODED

WATER WELL DRILLERS LOG

11-5-70 date well completed 1970 firm name HORACE A. POOLE county well located PEARL RIVER

LANDOWNER: DALLAS SMITH RT#2 Poplarville Miss (mailing address)

Table with 4 columns: description of formations encountered, from, to. Rows include: SURFACE CLAY (0-10), SANDY CLAY (10-25), SAND (25-40), SAND + PEABRAND (40-62)

WELL LOCATION: sec. 14 T 4 R 15 S 12 miles SE of Poplarville (distance, direction, nearest town)

WELL PURPOSE: FARM (home, irrigation, municipal, industrial)

- WELL COMPLETION DATA: (1) diameter (inches) 4 1/4 (2) total depth (feet) 62 (3) static water level (feet) 40 below top of ground. (4) casing PVC 57' (material), 2" (size) if telescope see back. (5) screen 10' 52" (length), 2" (size), PVC (material) (depth to top) (6) pump 1 (HP), 12 (yield gpm), elec (type power) (7) electric log no (yes or no) (organization running log) (8) how well bottom plugged BACKWASH VALVE


CODED

DRILLERS REMARKS:

DEC 2 1970

If well telescopes please sketch and show depths.

GROUND LEVEL

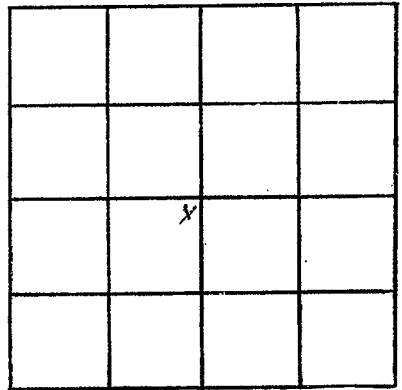

SECTION 14

Please indicate well location X.

ADDITIONAL INFORMATION

If more than one screen, show locations of each on sketch.