

P.R.
R17
5-5-73

MISSISSIPPI
BOARD OF WATER COMMISSIONERS
416 North State Street
Jackson, Mississippi 39201

CODED

WATER WELL DRILLERS LOG *Pearl River*

5-5 1973 *Earl Penton water well serv.*
date well completed firm name county well located

LANDOWNER:
Mr. Charles Lumpkin
Poltarville miss.
(mailing address)

description of formations encountered	from	to
<i>Red clay</i>	<i>0</i>	<i>21</i>
<i>Fine Red sd.</i>	<i>21</i>	<i>50</i>
<i>Coarse white sd.</i>	<i>50</i>	<i>66</i>

WELL LOCATION:
sec 3 T 4 N R 15 E
5 miles S.W. of Poltarville
(distance) (direction) (nearest town)

WELL PURPOSE: Home
(home, irrigation, municipal, industrial)

WELL COMPLETION DATA:

(1) diameter (inches) 8"

(2) total depth (feet) 66

(3) static water level (feet) 22 below above top of ground.

(4) casing P.V.C. 56'
(material) (depth)
4"
(size) if telescope see back.

(5) screen 10' 56'
(length) (depth to top)
4" P.V.C.
(size) (material)

(6) pump 1 735 H.P.
(HP) (yield gpm)
Elect
(type power)

(7) electric log NO
(yes or no)

(organization running log)

(8) how well bottom plugged Shoe


CODED

DRILLERS REMARKS:

APPROVED
8/19/73
JAMES W. ...

If well telescopes please sketch and show depths.

GROUND LEVEL

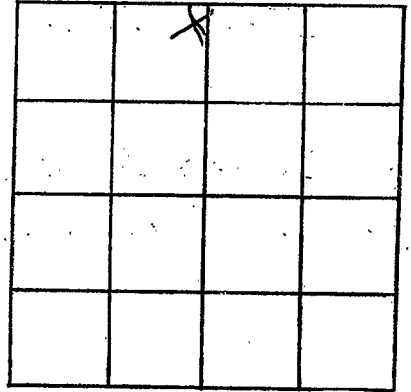

SECTION 3

Please indicate well location X.

ADDITIONAL INFORMATION

If more than one screen,
show locations of each on sketch.