

Pearl R.
R 18
1-18-74

MISSISSIPPI
BOARD OF WATER COMMISSIONERS
416 North State Street
Jackson, Mississippi 39201

WATER WELL DRILLERS LOG

CODED

1/18 1974 Budpentons & son Pearl River
date well completed firm name county well located

LANDOWNER: Albury
Anderson
Carriere Miss
(mailing address)

description of formations encountered	from	to
<u>Red shale</u>	<u>0</u>	<u>34</u>
<u>Red sand</u>	<u>34</u>	<u>60</u>

WELL LOCATION:
sec. 17 T 4 N R 18
5 miles E of Carriere
(distance) (direction) (nearest town)

WELL PURPOSE: home
(home, irrigation, municipal, industrial)

CODED

- WELL COMPLETION DATA:
- (1) diameter (inches) 4"
 - (2) total depth (feet) 60
 - (3) static water level (feet) 18 below top of ground.
 - (4) casing PVC 50
(material) (depth)
12 if telescope see back.
(size)
 - (5) screen 4x18 50
(length) (depth to top)
12 PVC
(size) (material)
 - (6) pump 1/2 450
(HP) (yield gpm)
Electr
(type power)
 - (7) electric log no
(yes or no)
 - (organization running log)
 - (8) how well bottom plugged handshank


DRILLERS REMARKS:

DISCONTINUED
MAY 21 1974

MISS. BD. OF WATER COMMISSIONERS

If well telescopes, please sketch and show depths.

GROUND LEVEL

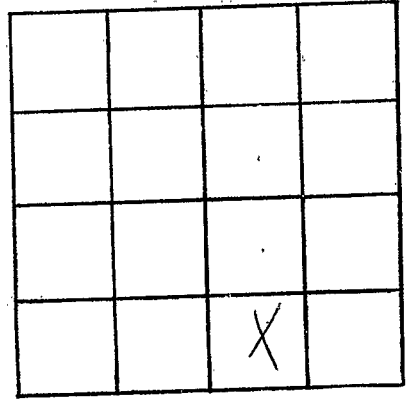

SECTION _____

Please indicate well location X.

ADDITIONAL INFORMATION

If more than one screen, show locations of each on sketch.