

Pearl River
R 19
3-6-74

MISSISSIPPI
BOARD OF WATER COMMISSIONERS
416 North State Street
Jackson, Mississippi 39201

CODED

WATER WELL DRILLERS LOG


3-6-74 date well completed
Earl Kenton water well serv. Pearl River firm name
county well located

LANDOWNER:	description of formations encountered	from	to
Billy Rowells Poffarville Miss. (mailing address)			
WELL LOCATION:	White clay	4	70
sec 29 T 2 N R 15 E 2 miles E of Poffarville (distance) (direction) (nearest town)	Blue clay	70	130
WELL PURPOSE: Home (home, irrigation, municipal, industrial)	Fine Red sd.	130	160
WELL COMPLETION DATA:	Blue clay	160	165
(1) diameter (inches) 7.5	Coarse yellow sd.	165	210
(2) total depth (feet) 210'			
(3) static water level (feet) 86 below top of ground			
(4) casing P.V.C. 200' (material) (depth) 4" (size) if telescope see back.			
(5) screen 10' 200' (length) (depth to top) 4" (size) P.V.C. (material)			
(6) pump 1 (HP) 785 g.p.m. (yield gpm) Elect (type power)			
(7) electric log NO (yes or no)			
(8) how well bottom plugged Shoe			
DRILLERS REMARKS:			

CODED

If well telescopes please sketch and show depths.

GROUND LEVEL

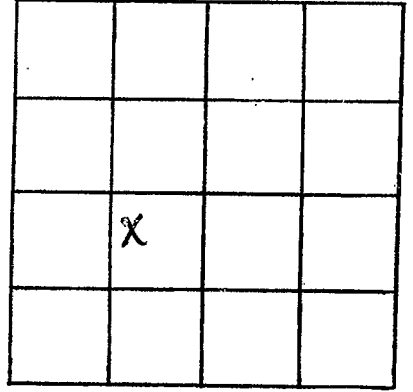

SECTION 29

Please indicate well location X.

ADDITIONAL INFORMATION

If more than one screen,
show locations of each on sketch.