

P.R.
R22
7-19-74

MISSISSIPPI
BOARD OF WATER COMMISSIONERS
416 North State Street
Jackson, Mississippi 39201

WATER WELL DRILLERS LOG *Part 1 River*

7-19-74 date well completed 1974 Earl Perton Water Well Serv. firm name Part 1 River county well located

LANDOWNER:
Mrs. Arthur Breland
Rt. 3 Poplarville Miss.
(mailing address)

WELL LOCATION:
sec *6* T *4* N R *15* E
4 miles *East* of *Millard*
(distance) (direction) (nearest town)

WELL PURPOSE: *Home*
(home, irrigation, municipal, industrial)

WELL COMPLETION DATA:

(1) diameter (inches) *4.5*

(2) total depth (feet) *85*

(3) static water level (feet) *54* below above top of ground.

(4) casing *PVC* *80*
(material) (depth)

(5) screen *5'* *80'*
(length) (depth to top)

2" *PVC*
(size) (material)

(6) pump *1* *450 P.H*
(HP) (yield gpm)


Elect.
(type power)

(7) electric log *NO*
(yes or no)

(8) how well bottom plugged *Shoe*

description of formations encountered	from	to
<i>Red Clay</i>	<i>0</i>	<i>14</i>
<i>Coarse white sh.</i>	<i>14</i>	<i>26</i>
<i>white clay</i>	<i>26</i>	<i>34</i>
<i>Blue Clay</i>	<i>34</i>	<i>64</i>
<i>Fine Blue sh.</i>	<i>64</i>	<i>78</i>
<i>Coarse Blue sh.</i>	<i>78</i>	<i>85</i>

CODED

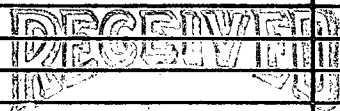

FEB 16 1975

DRILLERS REMARKS:

MISS. BD. OF WATER COM.

If well telescopes please sketch and show depths:

GROUND LEVEL



If more than one screen, show locations of each on sketch.

X			

SECTION 6

Please indicate well location X.

ADDITIONAL INFORMATION

