

Pearl R.  
R 24  
1-9-75

MISSISSIPPI  
BOARD OF WATER COMMISSIONERS  
416 North State Street  
Jackson, Mississippi 39201

CODE

WATER WELL DRILLERS LOG

1-9-1975 date well completed  
Simpkin Well Dr. firm name  
Pearl River county well located

LANDOWNER: Mrs. Lillie M...  
Rt. Poplarville Miss

description of formations encountered	from to	
Clay	0	15
Sandstone	15	30
Clay	30	255
Sand	255	276

(mailing address)

WELL LOCATION:  
sec. 13 T. 4 N. R. 15 E.  
11 miles S of Poplarville  
(distance) (direction) (nearest town)

WELL PURPOSE: Home  
(home, irrigation, municipal, industrial)

- WELL COMPLETION DATA:
- (1) diameter (inches) 2"
  - (2) total depth (feet) 276
  - (3) static water level (feet) 148' below top of ground.
  - (4) casing P.V.C., 270'  
(material) (depth)  
2" (size) if telescope see back.
  - (5) screen 6', 270'  
(length) (depth to top)  
2" P.V.C.  
(size) (material)
  - (6) pump 1/2 300 G.P.M.  
(HP) (yield gpm)  
Elec.  
(type power)
  - (7) electric log No.  
(yes or no)

(organization running log)  
(8) how well bottom plugged Sandstone


DRILLERS REMARKS:

RECORDED  
MAR 26 1975

MISS. DD. OF WATER COMM

If well telescopes please sketch and show depths.

GROUND LEVEL

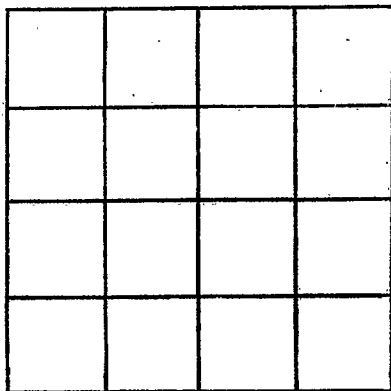

SECTION \_\_\_\_\_

Please indicate well location X.

ADDITIONAL INFORMATION

If more than one screen, show locations of each on sketch.