

MISSISSIPPI
 BOARD OF WATER COMMISSIONERS
 416 North State Street
 Jackson, Mississippi 39201

CODED

WATER WELL DRILLERS LOG

Pearl R.
 R. 25
 12-22-74

12-22-74
 date well completed

1974 Bud Linton & Son
 firm name

Pearl River
 county well located

LANDOWNER: T.A. Wallace

Poplarville, Miss

(mailing address)

description of formations encountered

Red Shale
 Blue Shale
 Red Sand
 Blue Shale
 Blue Sand

from

to

0 36
 36 160
 160 185
 185 205
 205 255

WELL LOCATION:

sec. 18 T. 4 N. R. 15 E.
 10 miles S-E Poplarville
 (distance) (direction) (nearest town)

WELL PURPOSE: Home
 (home, irrigation, municipal, industrial)

CODED

WELL COMPLETION DATA:

- (1) diameter (inches) 4 in
- (2) total depth (feet) 235
- (3) static water level (feet) 68 below top of ground.
- (4) casing PVC 205
 (material) (depth)

(size) if telescope see back.

- (5) screen 4x20 205
 (length) (depth to top)
 4x20 PVC
 (size) (material)
- (6) pump 2 1850
 (HP) (yield gpm)
 electric
 (type power)
- (7) electric log NO
 (yes or no)

(organization running log)

(8) how well bottom plugged
 Sand Shale

DRILLERS REMARKS:


RECEIVED

APR - 3 1975

MISSISSIPPI BOARD OF WATER COMMISSIONERS

If well telescopes please sketch and show depths.

GROUND LEVEL

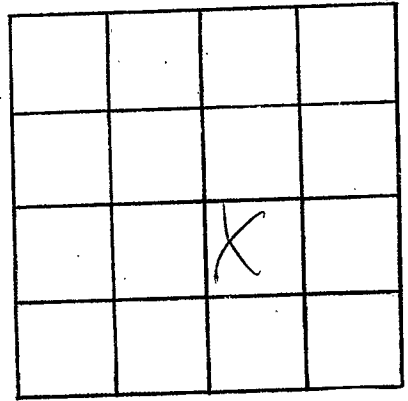

SECTION _____

Please indicate well location X.

ADDITIONAL INFORMATION

If more than one screen, show locations of each on sketch.