

MISSISSIPPI DEPARTMENT OF NATURAL RESOURCES

Bureau of Land and Water Resources

Southport Mall

P.O. Box 10631

Jackson, Mississippi 39209

WATER WELL DRILLERS LOG

CODED

PEARL RIVER
R 27
8/14/85

8-14 1985 PENTON WELL SERV Pearl River
date well completed firm name county well located

LANDOWNER: BRIAN PEARSON
PICAYUNE, MS
(mailing address)

WELL LOCATION:
sec. 18 T. 4 S. R. 15 E. W. Millard
7 miles SE of (distance) (direction) (nearest town)

WELL PURPOSE: HOME
(home, irrigation, municipal, industrial)

- WELL COMPLETION DATA:
- (1) diameter (inches) 2"
 - (2) total depth (feet) 755'
 - (3) static water level (feet) 90' below top of ground.
 - (4) casing PVC, 745' (material) (depth)
2" (size) if telescope see back.
 - (5) screen 10', 745' (length) (depth to top)
2" (size) PVC (material)
 - (6) pump 1 1/2 (HP) (yield gpm)
Elec (type power)
 - (7) electric log NO (yes or no)
(organization running log)
 - (8) how well bottom plugged B.W.

description of formations encountered	from to	
CLAY	0	20
SAND	20	30
CLAY	30	140
SAND	140	330
CLAY	330	690
SAND	690	755

CODED

RECEIVED


SEP - 9 1985

De Bureau of Land & Water Resources

DRILLERS REMARKS:

If well telescopes please sketch and show depths.

GROUND LEVEL

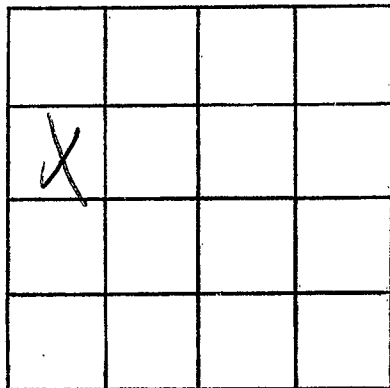

SECTION _____

Please indicate well location X.

ADDITIONAL INFORMATION

If more than one screen,
show locations of each on sketch.