

MISSISSIPPI DEPARTMENT OF NATURAL RESOURCES  
Bureau of Land and Water Resources

Southport Mall  
P.O. Box 10631

CODED

Jackson, Mississippi 39209  
WATER WELL DRILLERS LOG

P. RIVER
R 28

371

1-19 date well completed 1989 Bud penton firm name Pearl River county well located

LANDOWNER: Robert Taylor  
Millard Service Road  
PO Box Poplarville  
(mailing address) MS 39070

description of formations encountered	from	to
Red shale	0	10
Red sand	10	82
white shale	82	189
gray sand	189	357
blue shale	357	390
Blue sand gravel	390	415
blue shale	415	925
dry sand	925	1030

WELL LOCATION:  
sec. 6 T. 4 N. R. 15 E  
10 miles NE of Poplarville  
(distance) (direction) (nearest town)

WELL PURPOSE: water  
(home, irrigation, municipal, industrial)

WELL COMPLETION DATA:

(1) diameter (inches) 14"

(2) total depth (feet) 1030


(3) static water level (feet) 15-6 below above top of ground.

(4) casing PVC 1030  
(material) (depth)  
4x2 if telescope see back.  
(size)

(5) screen 15 1015  
(length) (depth to top)  
12 PVC  
(size) (material)

(6) pump 1/2 19  
(HP) (yield gpm)  
Elect.  
(type power)

(7) electric log no  
(yes or no)

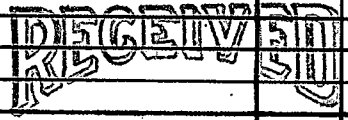

MAR 27 1989


Department of Natural Resources  
Bureau of Land & Water Resources

(organization running log)  
(8) how well bottom plugged Sand  
Shark

DRILLERS REMARKS:

If well telescopes please sketch and show depths.

GROUND LEVEL

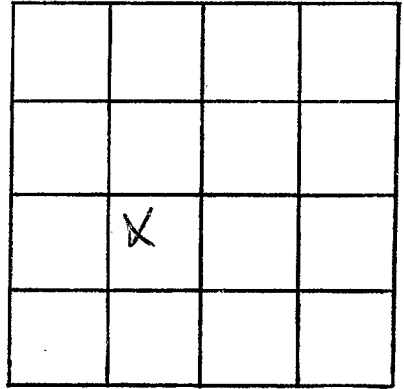

SECTION \_\_\_\_\_

Please indicate well location X.

ADDITIONAL INFORMATION

If more than one screen,  
show locations of each on sketch.