

MISSISSIPPI DEPARTMENT OF NATURAL RESOURCES

Bureau of Land and Water Resources

Southport Mall

P.O. Box 10631

Jackson, Mississippi 39209

WATER WELL DRILLERS LOG

L. RIVER
R 31

CODED

4-1 19 93 Bud Penton Water Well Pearl River
date well completed firm name county well located

LANDOWNER: Louis Jacobson
716 Cybur Hills
Carriere Ms 39426
(mailing address)

WELL LOCATION:
sec. 21 T. 4 N. R. 15 E
S W
3 miles S of Henleyfield
(distance) (direction) (nearest town)

WELL PURPOSE: Home
(home, irrigation, municipal, industrial)

WELL COMPLETION DATA:
(1) diameter (inches) 7
(2) total depth (feet) 810
(3) static water level (feet) 65 below above
top of ground.
(4) casing PVC, 800
(material) (depth)
4"x2" if telescope see back.
(size)
(5) screen 10, 800
(length) (depth to top)
2, PVC
(size) (material)
(6) pump 1, 18
(HP) (yield gpm)
elec.
(type power)
(7) electric log NO
(yes or no)
(organization running log)
(8) how well bottom plugged
sand shark

description of formations encountered	from	to
white clay	0	18
red sand	18	80
white clay	80	95
white sand	95	130
blue clay	130	258
gray sand	258	420
blue clay clay	420	480
blue sand	480	510
blue clay	510	770
gray sand	770	810

RECEIVED

JUN 28 1993

Dept. of Environmental Quality
Office of Land & Water Resources


DRILLERS REMARKS:

If well telescopes please sketch and show depths.

GROUND LEVEL

150'4"

660'2"

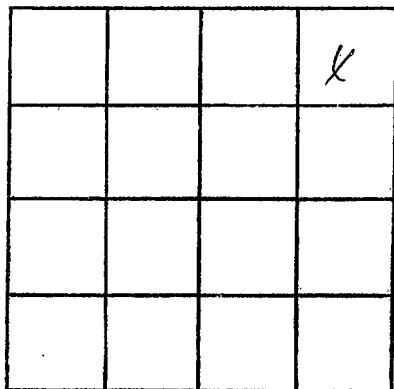

SECTION 21

Please indicate well location X.

ADDITIONAL INFORMATION

If more than one screen,
show locations of each on sketch.