

R 2000
8-6-65

WATER WELL DRILLERS LOG

Date: Aug 6, 1965, Driller: J. B. [Signature] County: Pearl River
(Name)

(1) Owner of Land: A. J. Baucum
(Name)
Rt 1 Cassiere Min
(Address)
(2) Location: NE 1/4, NW 1/4, Sec 28, T4, R14
4 miles East of Adrian
(distance) (direction) (Nearest Town)
(3) Topography: (Hilly) (Flat) (Level)
(4) Purpose of Well: Home
(Domestic Irrigation
Municipal, Industrial, Other)


Description & Color of Materials Sand, Clay, Red Clay, Shell, etc.	Thick- ness Feet	Depth Feet
<u>Red Clay</u>	<u>60</u>	<u>60</u>
<u>white sand</u>	<u>70</u>	<u>130</u>
<u>white shell mud</u>	<u>40</u>	<u>170</u>
<u>Hard Blue mud</u>	<u>50</u>	<u>220</u>
<u>water sand</u>	<u>30</u>	<u>250</u>

Information upon completion of well:

(1) Diameter 2 1/4 inches.
(2) Total Depth 250 feet.
(3) Water Level 80 feet below top of ground.
(4) Cased to _____, Size _____
(5) Screen: Size 1/4, Length 15 ft
(6) Were any formations sealed against pollution?
_____ yes, _____ no.

If YES depth of formation _____
Why _____

Drillers Remarks: _____

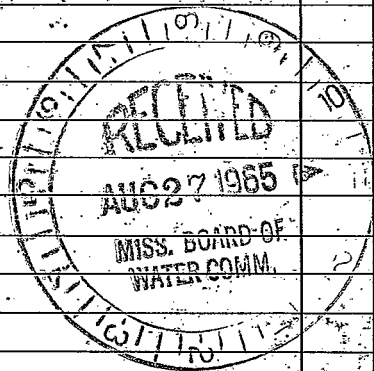

(Use Back Side)

Well No. _____

