

Pearl River

MISSISSIPPI BOARD OF WATER COMMISSIONERS

R 2001

2

3-68

WATER WELL DRILLERS LOG

Date: 3/28, 1968, Driller: POUPART

PEARL RIVER County


(1) Owner of Land: J CUNNINGHAM  
 (Name)  
 RT2 CARRIER  
 (Address)  
 ASHALL H RAVLH  
 (2) Location: 2 1/4, SW 1/4, Sec. 20 T4 R15 W5  
 8 miles East of McNeill  
 (distance) (direction) (Nearest Town)  
 (3) Topography:  (Hilly)  (Flat)  (Level)  
 (4) Purpose of Well: Domestic  
 (Domestic Irrigation, Municipal, Industrial, Other)

Description & Color of Materials Sand, Clay, Red Clay, Shell, etc.	Thick- ness Feet	Depth Feet
SAND + GRAVEL		20
Clay Bed	30	70
Blue Clay chkb	160	180
Fine SAND		
Green	40	220
Coarse SAND	22	242

Information upon completion of well:

(1) Diameter 7 inches.  
 (2) Total Depth 242 feet.  
 (3) Water Level 115 feet below top of ground.  
 (4) Cased to 242, Size 4"  
 (5) Screen: Size 6/12, Length 90"  
 (6) Were any formations sealed against pollution?  
 \_\_\_\_\_ yes, \_\_\_\_\_ no.

If YES depth of formation \_\_\_\_\_  
 Why \_\_\_\_\_  
 Drillers Remarks: \_\_\_\_\_

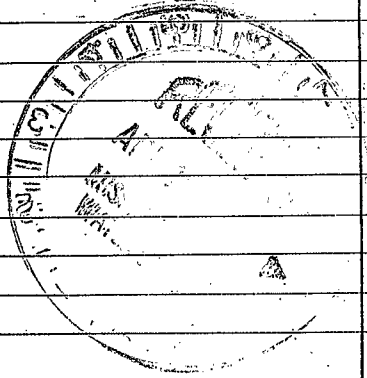

(Use Back Side)

Well No.

[The page contains extremely faint and illegible text, likely bleed-through from the reverse side of the document. No specific words or phrases can be discerned.]