

Pearl River
R 2002
2-1-76

MISSISSIPPI
 BOARD OF WATER COMMISSIONERS
 416 North State Street
 Jackson, Mississippi 39201

WATER WELL DRILLERS LOG

2-1 1976 The Pouncey water wells Pearl River
 date well completed firm name county well located

LANDOWNER: Mr. Clifton
Simoneaux
Red - Poplarville -
Address Applied -
 (mailing address)

description of formations encountered	from	to
<u>clay</u>	<u>0</u>	<u>16</u>
<u>sd</u>	<u>16</u>	<u>28</u>
<u>white yellow clay</u>	<u>28</u>	<u>70</u>
<u>Blue clay</u>	<u>70</u>	<u>92</u>
<u>sd - FAULT zone</u>	<u>92</u>	<u>126</u>

WELL LOCATION:
 sec. 7 T. 7 N. R. 15 E.
4 miles SE of Millwood
 (distance) (direction) (nearest town)

WELL PURPOSE: none
 (home, irrigation, municipal, industrial)

- WELL COMPLETION DATA:
- (1) diameter (inches) 4
 - (2) total depth (feet) 126
 - (3) static water level (feet) 90 below top of ground.
 - (4) casing PVC 126
 (material) (depth)
4 if telescope see back.
 (size)
 - (5) screen 5 121
 (length) (depth to top)
4 PVC
 (size) (material)
 - (6) pump 3/4 sub 20
 (HP) (yield gpm)
220V AC
 (type power)
 - (7) electric log yes or no
 - (8) how well bottom plugged Sealed


DRILLERS REMARKS: Very
hd - well to 13,000
down - washed
got - H₂O

RECEIVED
 FEB 18 1977

MISS. DD OF WATER COMM

If well telescopes please sketch and show depths.

GROUND LEVEL

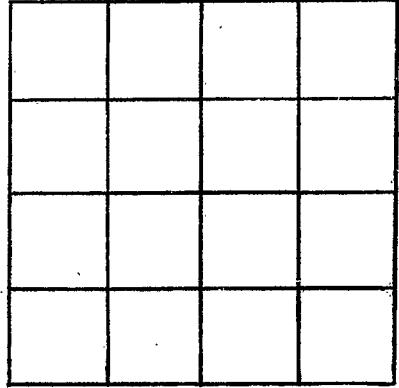

SECTION _____

Please indicate well location X.

ADDITIONAL INFORMATION

If more than one screen, show locations of each on sketch.