

Pearl R.
 R 2003
 1/26/79

MISSISSIPPI
 BOARD OF WATER COMMISSIONERS
 416 North State Street
 Jackson, Mississippi 39201

WATER WELL DRILLERS LOG

1/26 date well completed 1979 Bud Spanton firm name Pearl River county well located

LANDOWNER: Anderson E
Anderson
 (mailing address)
 WELL LOCATION:
 sec. 10 T. 4 N. R. 15 E.
15 miles SE of Poplarville
 (distance) (direction) (nearest town)

description of formations encountered	from	to
Red shale	0	85
Blue shale	85	175
gray sand	175	225
Blue shale	225	300
gray sand	300	330

WELL PURPOSE: home
 (home, irrigation, municipal, industrial)

- WELL COMPLETION DATA:
- (1) diameter (inches) 4"
 - (2) total depth (feet) 330
 - (3) static water level (feet) 126 below above top of ground.
 - (4) casing PVC 330
 (material) (depth)
 (size) if telescope see back.
 - (5) screen 4" 320
 (length) (depth to top)
12 PVC
 (size) (material)
 - (6) pump 1 1/2 1315
 (HP) (yield gpm)
Elect
 (type power)
 - (7) electric log NO
 (yes or no)

(organization running log)
 (8) how well bottom plugged Hard

DRILLERS REMARKS:


Miss. Board of Water Comm.

JUL 30 1979

RECEIVED

If well telescopes please sketch and show depths.

GROUND LEVEL

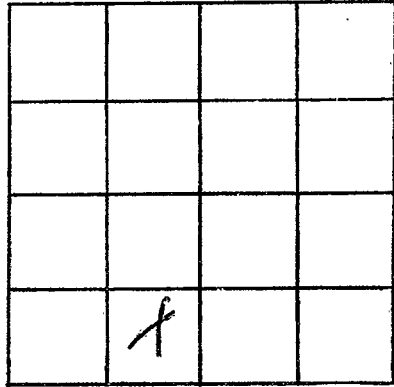

SECTION _____

Please indicate well location X.

ADDITIONAL INFORMATION

If more than one screen, show locations of each on sketch.