

Pearl R.
R 2004
7-21-79

MISSISSIPPI
 BOARD OF WATER COMMISSIONERS
 416 North State Street
 Jackson, Mississippi 39201

WATER WELL DRILLERS LOG

date well completed July 21 1979 firm name Amuraw Well Drilling county well located Pearl River

LANDOWNER: <u>Jim Papp</u> <u>124 Mink Drive</u>	description of formations encountered	from	to
<u>Arabi La</u> (mailing address)	<u>Clay</u>	<u>0</u>	<u>30</u>
WELL LOCATION: sec. <u>19</u> T. <u>4</u> N. R. <u>XX</u> E. <u>8</u> miles <u>E.</u> of <u>McNeil</u> (distance) (direction) (nearest town)	<u>Blue clay</u>	<u>30</u>	<u>250</u>
WELL PURPOSE: <u>Home</u> (home, irrigation, municipal, industrial)	<u>fine sand</u>	<u>250</u>	<u>300</u>
WELL COMPLETION DATA: (1) diameter (inches) <u>2x4 135' 2"</u>	<u>Course sand</u>	<u>300</u>	<u>315</u>
(2) total depth (feet) <u>315 ft.</u>			
(3) static water level (feet) <u>120'</u> below top of ground.			
(4) casing <u>PVC</u> , <u>30.5'</u> (material) (depth)			
(5) screen <u>10'</u> , <u>305'</u> (length) (depth to top)			
2" (size), <u>PVC</u> (material)			
(6) pump <u>1 sub.</u> , <u>10</u> (HP) (yield gpm)			
<u>electric</u> (type power)			
(7) electric log _____ (yes or no)			
(8) how well bottom plugged <u>Sand</u>			
DRILLERS REMARKS: <u>Mark</u>			


DEPT. OF NATURAL RESOURCES
 BUREAU OF LAND & WATER RESOURCES

JAN 14 1980

RECEIVED

If well telescopes please sketch and show depths.

GROUND LEVEL

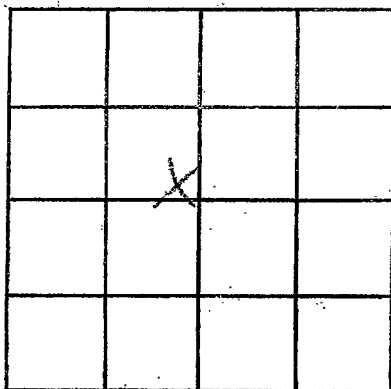

SECTION 19

Please indicate well location X.

ADDITIONAL INFORMATION

If more than one screen,
show locations of each on sketch.