

Pearl River
 R 2000
 6-5-80

MISSISSIPPI
 BOARD OF WATER COMMISSIONERS
 416 North State Street
 Jackson, Mississippi 39201

WATER WELL DRILLERS LOG

6/5-80 date well completed 1980 Pearl River County Pearl River
 firm name Water Well Service county well located

LANDOWNER	description of formations encountered	from	to
Earl Whetford			
B.T. & Bob	234 Poplar	0	30
Miss.	Blue shale	50	300
	Gray sand	300	340

WELL LOCATION:
 sec. 3 T. 4 N. R. 15 E.
 12 miles S East of (nearest town)

WELL PURPOSE: home
 (home, irrigation, municipal, industrial)

- WELL COMPLETION DATA:
- (1) diameter (inches) 4"
 - (2) total depth (feet) 346
 - (3) static water level (feet) 175 below top of ground
 - (4) casing PVC, 336 (material) (depth)
 (size) if telescope see back.
 - (5) screen 10, 336 (length) (depth to top)
 1/2" PVC (size) (material)
 - (6) pump 1/2 (HP) 1650 gpm (yield gpm)
 - (type power)
 - (7) electric log Elect. (yes or no)
 no (organization running log)
 - (8) how well bottom plugged Sand

DRILLERS REMARKS:


DEPT. OF NATURAL RESOURCES
 BUREAU OF LAND & WATER RESOURCES

NOV 13 1980

RECEIVED

If well telescopes please sketch and show depths.

GROUND LEVEL

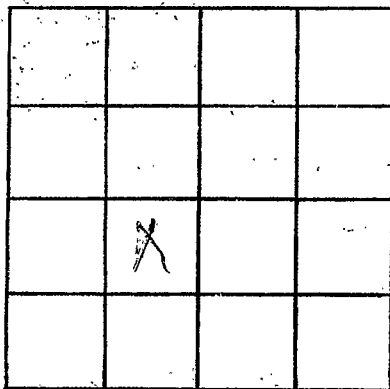

SECTION _____

Please indicate well location X.

ADDITIONAL INFORMATION

Lined area for additional information.

If more than one screen, show locations of each on sketch.