

PEARL RIVER  
R 2007  
11/1/80  
11-1 19

MISSISSIPPI  
 BOARD OF WATER COMMISSIONERS  
 416 North State Street  
 Jackson, Mississippi 39201




WATER WELL DRILLERS LOG

BOUNCY WATER WELL DRILLING Pearl River  
 firm name county well located


LANDOWNER: <u>M.R.E.D. Holge</u>	description of formations encountered	from	to
<u>Sheep Hollow Community</u>			
(mailing address)	<u>to clay -</u>	<u>0</u>	<u>14</u>
WELL LOCATION:	<u>Red Tank rd -</u>	<u>14</u>	<u>110</u>
sec. <u>24</u> T. <u>4</u> N. R. <u>15</u> E <u>12</u> miles <u>S</u> of <u>Poplarville</u> (distance) (direction) (nearest town)			
WELL PURPOSE: <u>Home</u> (home, irrigation, municipal, industrial)			
WELL COMPLETION DATA:			
(1) diameter (inches) <u>4</u>			
(2) total depth (feet) <u>110</u>			
(3) static water level (feet) <u>60</u> below top of ground			
(4) casing <u>PVC</u> , <u>105</u> (material) (depth)			
<u>4</u> (size) if telescope see back.			
(5) screen <u>5</u> (length) <u>105</u> (depth to top)			
<u>4</u> (size) <u>PVC</u> (material)			
(6) pump <u>1/2</u> (HP) <u>4</u> (yield gpm)			
<u>AC</u> (type power)			
(7) electric log <u>yes</u> (yes or no)			
(organization running log)			
(8) how well bottom plugged			

DRILLERS REMARKS:  
Slow Slow Recovery -

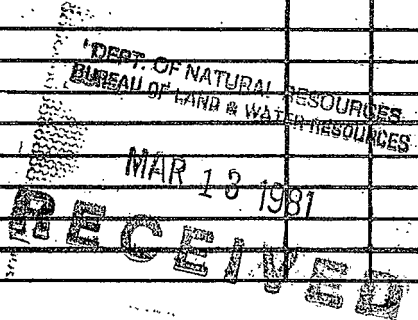

If well telescopes please sketch and show depths.

GROUND LEVEL

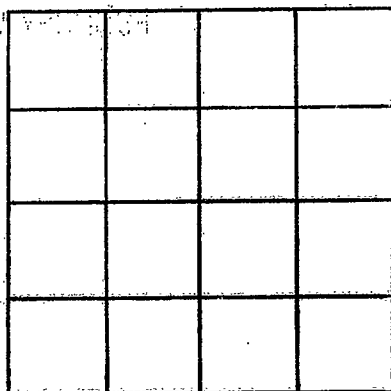

SECTION \_\_\_\_\_

Please indicate well location X.

ADDITIONAL INFORMATION

If more than one screen, show locations of each on sketch.