

Pearl Rv  
R-2008  
6-18-81

MISSISSIPPI  
BOARD OF WATER COMMISSIONERS  
416 North State Street  
Jackson, Mississippi 39201

WATER WELL DRILLERS LOG  
BRADEN PUMP AND WELL SERVICE, INC.

6-18 1981 date well completed  
ROUTE 1, BOX 489 SAUCIER, MS 39574  
PEARL RIVER county well located


LANDOWNER: T.M. Allen  
Rt. 4  
Poplarville, MS 39470  
(mailing address)

description of formations encountered	from to	
Clay Sand	0	20
	20	80

WELL LOCATION:  
sec. 10 T 4 N R 15 W  
S W  
2 miles S of Savannah  
(distance) (direction) (nearest town)

WELL PURPOSE: HOME  
(home, irrigation, municipal, industrial)


- WELL COMPLETION DATA:
- (1) diameter (inches) 2"
  - (2) total depth (feet) 80'
  - (3) static water level (feet) SS below top of ground.
  - (4) casing PVC total  
(material) (depth)  
2" if telescope see back.  
(size)
  - (5) screen 10' 65'  
(length) (depth to top)  
2" PVC under bar  
(size) (material)
  - (6) pump 1 3  
(HP) (yield gpm)  
230  
(type power)
  - (7) electric log NO  
(yes or no)
  - (organization running log)
  - (8) how well bottom plugged  
2" SAND SHARK

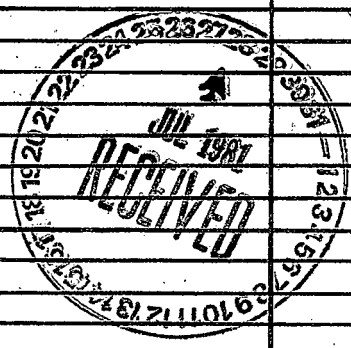

DRILLERS REMARKS:  
5' tail pipe

If well telescopes please sketch and show depths.

GROUND LEVEL

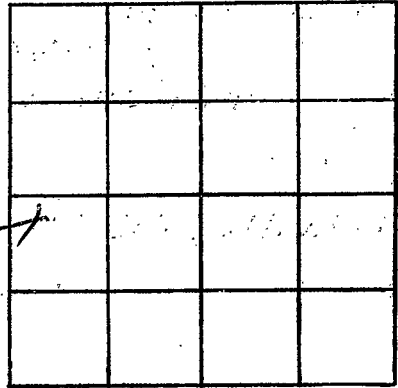

SECTION 10

Please indicate well location X.

ADDITIONAL INFORMATION

If more than one screen, show locations of each on sketch.