

MISSISSIPPI DEPARTMENT OF NATURAL RESOURCES

Bureau of Land and Water Resources

Southport Mall

P.O. Box 10631

Jackson, Mississippi 39209

WATER WELL DRILLERS LOG

Pearl River
R 2009
1981

date well completed 19 Walker Well Drilling Pearl River  
Nov 6-81 firm name Walker Well Drilling county well located

LANDOWNER Minnie Culpepper

description of formations encountered	from	to
Red shale	0	65
fine sand	65	77
limestone shale	77	254
course limestone	254	298

R 4 Poplarville, Miss (mailing address)

WELL LOCATION:  
 sec. 4 T 4 S R 15 W  
5 miles S Poplarville  
 (distance) (direction) (nearest town)

WELL PURPOSE: home  
 (home, irrigation, municipal, industrial)

WELL COMPLETION DATA:

- (1) diameter (inches) 2"
- (2) total depth (feet) 298'
- (3) static water level (feet) 178 below top of ground.
- (4) casing PVC 288'  
 (material) (depth)
- (size) if telescope see back.
- (5) screen 10' 288  
 (length) (depth to top)
- 12 Royal PVC  
 (size) (material)
- (6) pump 1 1/2 6  
 (HP) (yield gpm)
- 600  
 (type power)
- (7) electric log (yes or no)

(organization running log)

(8) how well bottom plugged Drilled  
Shank

DRILLERS REMARKS:


DEPT. OF NATURAL RESOURCES  
 BUREAU OF LAND & WATER RESOURCES

NOV 23 1981

RECEIVED

If well telescopes please sketch and show depths.

GROUND LEVEL

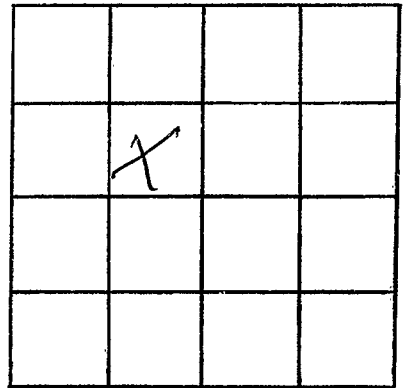

SECTION \_\_\_\_\_

Please indicate well location X. ✓

ADDITIONAL INFORMATION

If more than one screen,  
show locations of each on sketch.