

MISSISSIPPI DEPARTMENT OF NATURAL RESOURCES

Bureau of Land and Water Resources

Southport Mall

P.O. Box 10631

Jackson, Mississippi 39209

WATER SUPPLY DRILLERS LOG
WATER WELL SERVICE

ROUTE 3 BOX 41
CARRIERE, MS 39426

PHONE 798-5324

Pearl River
county well located

Pearl River
R 2010
6-21-81

6-21 19 81
date well completed

LANDOWNER: Donald Chaffin
Chisholm Road RD.
Merrel MS
(mailing address)

description of formations encountered	from	to
<u>Grey Shale</u>	<u>0</u>	<u>40</u>
<u>Blue Shale</u>	<u>40</u>	<u>120</u>
<u>gray sand</u>	<u>120</u>	<u>185</u>

WELL LOCATION:
sec 20 T 4 N R 15 E
5 miles E of Merrel
(distance) (direction) (nearest town)

WELL PURPOSE: Home
(home, irrigation, municipal, industrial)

- WELL COMPLETION DATA:
- (1) diameter (inches) 4"
 - (2) total depth (feet) 185'
 - (3) static water level (feet) 95 below above top of ground.
 - (4) casing PVC 175'
(material) (depth)
 - (size) if telescope see back.
 - (5) screen 10' 175'
(length) (depth to top)
 - 4 PVC
(size) (material)
 - (6) pump 3/4 1000
(HP) (yield gpm)
 - slc
(type power)
 - (7) electric log _____
(yes or no)

(organization running log)

(8) how well bottom plugged slc
slc

DRILLERS REMARKS: _____


DEPT. OF NATURAL RESOURCES
BUREAU OF LAND & WATER RESOURCES

NOV 9 - 1981

RECEIVED

If well telescopes please sketch and show depths.

GROUND LEVEL

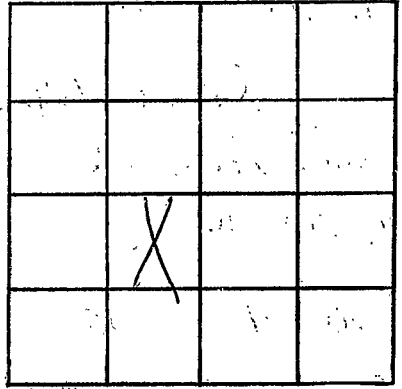

SECTION _____

Please indicate well location X.

ADDITIONAL INFORMATION

If more than one screen,
show locations of each on sketch.