

MISSISSIPPI DEPARTMENT OF NATURAL RESOURCES

Bureau of Land and Water Resources

Southport Mall

P.O. Box 10631

Jackson, Mississippi 39209

WATER WELL DRILLERS LOG

Paul Rivers
R2013

Feb 8 1982
date well completed

Bud Linton & Son
firm name

Paul River
county well located

LANDOWNER: *Mr. Wayne Mitchell*
Enshelch Ranch -
Poplarville MS.
(mailing address)

description of formations encountered	depth	
	from	to
<i>White shale</i>	<i>0</i>	<i>93</i>
<i>gray shale</i>	<i>43</i>	<i>60</i>
<i>light blue</i>	<i>60</i>	<i>93</i>
<i>Blue Shale</i>	<i>93</i>	<i>160</i>
<i>gray sand</i>	<i>160</i>	<i>190</i>

WELL LOCATION:
sec. *17* T. *4* N R. *15* E
S W
10 miles *E* of *Mail*
(distance) (direction) (nearest town)

WELL PURPOSE: *Home*
(home, irrigation, municipal, industrial)

- WELL COMPLETION DATA:
- (1) diameter (inches) *4"*
 - (2) total depth (feet) *190'*
 - (3) static water level (feet) *90'* below above top of ground.
 - (4) casing *PVC* *190'*
(material) (depth)
if telescope see back.
 - (5) screen *10'* *180'*
(length) (depth to top)
4" *PVC*
(size) (material)
 - (6) pump *1* *900*
(HP) (yield gpm)
clot
(type power)
 - (7) electric log _____
(yes or no)
(organization running log)
 - (8) how well bottom plugged *dup*
shap

DRILLERS REMARKS: _____


DEPT. OF NATURAL RESOURCES
BUREAU OF LAND & WATER RESOURCES

MAR 26 1982

RECEIVED

If well telescopes please sketch and show depths.

GROUND LEVEL

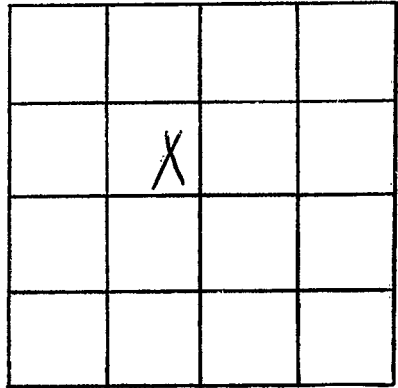

SECTION _____

Please indicate well location X.

ADDITIONAL INFORMATION

If more than one screen, show locations of each on sketch.