

Pearl River
R 2015
1-6-82

MISSISSIPPI DEPARTMENT OF NATURAL RESOURCES
 Bureau of Land and Water Resources
 Southport Mall
 P.O. Box 10631
 Jackson, Mississippi 39209
WATER WELL DRILLERS LOG

Jan. 6 1982 Braden Pump & Well Service, Pearl River

date well completed (Well #1) 19 firm name Inc. county well located

LANDOWNER: Emmett Woods

#2 Cleveland Ct.

Metairie, La. 70002

(mailing address)

WELL LOCATION:

sec. 16 4 N R 15 E
 S W
3 miles S.E. of Savannah
 (distance) (direction) (nearest town)

WELL PURPOSE: Home
 (home, irrigation, municipal, industrial)

WELL COMPLETION DATA:

- (1) diameter (inches) 2"
- (2) total depth (feet) 80 Ft.
- (3) static water level (feet) 50 below top of ground. ~~xxxxx~~
- (4) casing PVC 75 ft.
 (material) (depth)
2" if telescope see back.
 (size)
- (5) screen 5 Ft. 75 Ft.
 (length) (depth to top)
2" PVC Underbar
 (size) (material)
- (6) pump 1 8
 (HP) (yield gpm)
220 V. 1Ø
 (type power)
- (7) electric log no
 (yes or no)
 (organization running log)

(8) how well bottom plugged
2" PVC sand shark


description of formations encountered	from	to
	Clay	0
Sand & gravel	10	80

DRILLERS REMARKS:

DEPT. OF NATURAL RESOURCES
 BUREAU OF LAND & WATER RESOURCES
 SEP 10 1982
RECEIVED

If well telescopes please sketch and show depths.

GROUND LEVEL

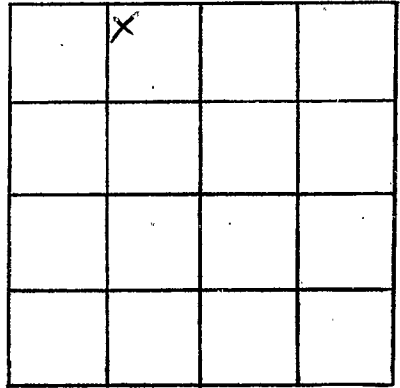

SECTION 3

Please indicate well location X.

ADDITIONAL INFORMATION

If more than one screen,
show locations of each on sketch.