

MISSISSIPPI DEPARTMENT OF NATURAL RESOURCES

Bureau of Land and Water Resources
 Southport Mall
 P.O. Box 10631
 Jackson, Mississippi 39209

RUD BENTON & SON
 WATER WELL SERVICE
 ROUTE BOX
 CARRIERE, MS 39426
 PHONE 798-5324

BUREAU OF LAND AND WATER RESOURCES
 WATER WELL SERVICE
 ROUTE 4 BOX 402
 CARRIERE, MS 39426
 PHONE 798-5324

Pearl River
R
2017

10/15 1982
 date well completed

Pearl River
 county well located

LANDOWNER: Clara Gables

description of formations encountered

from to

RJ-4 Bot 158 poplar

Red shale

0 26

Miss.

White shale

26 142

(mailing address)

Gray sand

142 168

WELL LOCATION:

sec. 6 T. 14 N. R. 15 E.
 S. W.
1.2 miles N of Merrel
 (distance) (direction) (nearest town)

WELL PURPOSE: Home
 (home, irrigation, municipal, industrial)

WELL COMPLETION DATA:

- (1) diameter (inches) 4"
- (2) total depth (feet) 168
- (3) static water level (feet) 62 below above top of ground.
- (4) casing pcv 168
 (material) (depth)
 (size) if telescope see back.
- (5) screen 4x10 158
 (length) (depth to top)
12 pcv
 (size) (material)
- (6) pump 1/2 650
 (HP) (yield gpm)
Elect.
 (type power)
- (7) electric log no
 (yes or no)

(organization running log)

(8) how well bottom plugged sharp


DRILLERS REMARKS:

DEPT. OF NATURAL RESOURCES
 BUREAU OF LAND & WATER RESOURCES

DEC - 1 1982
 RECEIVED

If well telescopes please sketch and show depths.

GROUND LEVEL

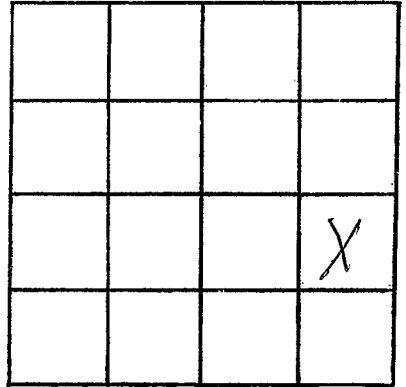

SECTION _____

Please indicate well location X.

ADDITIONAL INFORMATION

If more than one screen,
show locations of each on sketch.