

MISSISSIPPI DEPARTMENT OF NATURAL RESOURCES

Bureau of Land and Water Resources

Southport Mall

P.O. Box 10631

Jackson, Mississippi 39209

WATER WELL DRILLERS LOG

POUNCEY WATER WELL DRILLING

Pearl River
R2018
3/26/83

Pearl River

3-26
date well completed

1983

firm name

county well located

LANDOWNER:	description of formations encountered	from	to
Rodney Spears - Smith - Rd - Poplarville RFD - (mailing address)	Top - S - Clay	0	6 6 80
WELL LOCATION: sec. 7 T. 4 N. R. 15 E 3 miles E of Millbrook (distance) (direction) (nearest town)	Clay	30	80
WELL PURPOSE: (home, irrigation, municipal, industrial)	Clay	80	115
WELL COMPLETION DATA: (1) diameter (inches) 2 (2) total depth (feet) 115 (3) static water level (feet) 92 below top of ground. (4) casing PVC (material), 105 (depth) (size) If telescope see back. (5) screen 10 (length), 105 (depth to top) (size) PVC (material) (6) pump 1 (HP), 6 (yield gpm) AC (type power) (7) electric log (yes or no) (organization running log) (8) how well bottom plugged Sealed			
DRILLERS REMARKS:			


DEPT. OF NATURAL RESOURCES
BUREAU OF LAND & WATER RESOURCES

MAY 18 1983

RECEIVED

If well telescopes please sketch and show depths.

GROUND LEVEL

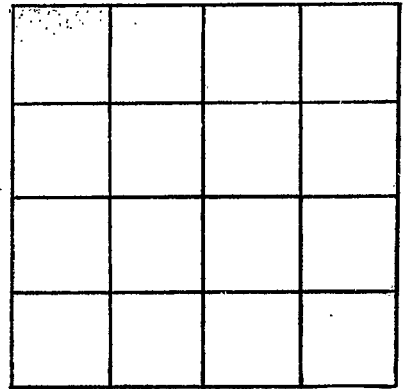

SECTION _____

Please indicate well location X.

ADDITIONAL INFORMATION

If more than one screen,
show locations of each on sketch.