

MISSISSIPPI DEPARTMENT OF NATURAL RESOURCES

Bureau of Land and Water Resources

Southport Mall

P.O. Box 10631

Jackson, Mississippi 39209

WATER WELL DRILLERS LOG

Pearl River  
RR  
209

June 8 1983 Walker Wellboring Pearl River  
 date well completed      firm name      county well located

LANDOWNER: Sealver Farms  
Ernstallah Ranch  
Picayune Miss  
 (mailing address)

description of formations encountered	from	to
	<u>Red shale</u>	<u>0</u>
<u>Sand</u>	<u>65</u>	<u>73</u>
<u>White Chalk</u>	<u>73</u>	<u>148</u>
<u>Sand</u>	<u>148</u>	<u>172</u>

WELL LOCATION:

sec 20 T 4 S R 15 W  
9 miles E of Merid  
 (distance)      (direction)      (nearest town)

WELL PURPOSE: Home  
 (home, irrigation, municipal, industrial)

WELL COMPLETION DATA:

(1) diameter (inches) 4"  
 (2) total depth (feet) 172'  
 (3) static water level (feet) 85 below ~~above~~ top of ground.

(4) casing PVC 162'  
 (material)      (depth)  
 \_\_\_\_\_ if telescope see back.  
 (size)  
 (5) screen 10' 162'  
 (length)      (depth to top)  
12" PVC  
 (size)      (material)

(6) pump 6 6  
 (HP)      (yield gpm)  
Elec  
 (type power)

(7) electric log \_\_\_\_\_  
 (yes or no)  
 \_\_\_\_\_  
 (organization running log)

(8) how well bottom plugged Sand  
Shrub

DRILLERS REMARKS:  
 \_\_\_\_\_  
 \_\_\_\_\_


DEPT. OF NATURAL RESOURCES  
 BUREAU OF LAND & WATER RESOURCES

JUN 14 1983

RECEIVED

If well telescopes please  
sketch and show depths.

GROUND LEVEL

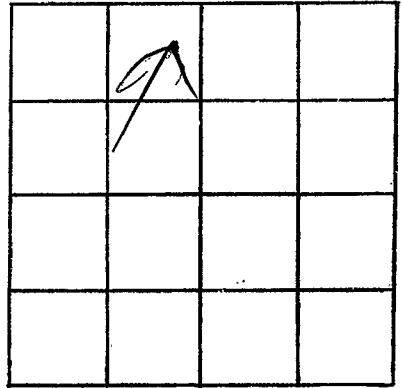

SECTION \_\_\_\_\_

Please indicate well location X.

ADDITIONAL INFORMATION

If more than one screen,  
show locations of each on sketch.