

MISSISSIPPI DEPARTMENT OF NATURAL RESOURCES

Bureau of Land and Water Resources

Southport Mall

P.O. Box 10631

Jackson, Mississippi 39209

WATER WELL DRILLERS LOG

Pearl River
R
2001

7-16-83 19 Walker Welding and Repair Pearl River
 date well completed firm name county well located

LANDOWNER:	description of formations encountered	from	to
Bobby Allen Poplarville Ms. (mailing address)			
	Fine Sand	25	30
	Blue Clay	30	40
	Sand and Gravel	40	78
WELL LOCATION:			
sec. <u>14</u> T <u>4</u> S R <u>15</u> E W			
<u>16</u> miles <u>East</u> of <u>McNair</u> (distance) (direction) (nearest town)			
WELL PURPOSE: <u>Home</u> (home, irrigation, municipal, industrial)			
WELL COMPLETION DATA:			
(1) diameter (inches) <u>2</u>			
(2) total depth (feet) <u>78</u>			
(3) static water level (feet) <u>28</u> <u>below</u> top of ground. <u>above</u>			
(4) casing <u>PVC</u> , <u>68</u> (material) (depth) (size) If telescope see back.			
(5) screen <u>10</u> , <u>68</u> (length) (depth to top) <u>12</u> , <u>PVC</u> (size) (material)			
(6) pump <u>1/2</u> , <u>10</u> (HP) (yield gpm) <u>Electric</u> (type power)			
(7) electric log <u>no</u> (yes or no) (organization running log)			
(8) how well bottom plugged <u>Sand Shark</u>			
DRILLERS REMARKS:			


DEPT. OF NATURAL RESOURCES
 BUREAU OF LAND & WATER RESOURCES

AUG 8 1983

RECEIVED

If well telescopes please sketch and show depths.

GROUND LEVEL

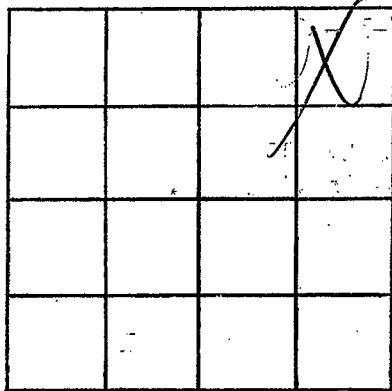

SECTION _____

Please indicate well location X.

ADDITIONAL INFORMATION

If more than one screen,
show locations of each on sketch.