

MISSISSIPPI DEPARTMENT OF NATURAL RESOURCES

Bureau of Land and Water Resources

Southport Mall

P.O. Box 10631

Jackson, Mississippi 39209

WATER WELL DRILLERS LOG

Paul River
R
2002

8-3 1983 Walker's Welding and Repair Pearl River
 date well completed firm name county well located

LANDOWNER: <u>William White</u> <u>McNeil Ms</u>	description of fomations encountered	from	to
(mailing address)			
WELL LOCATION: sec. <u>3</u> T. <u>4</u> N. R. <u>15</u> W. S. W.	<u>Blue Shale</u>	<u>10</u>	<u>90</u>
<u>1/2</u> miles <u>East</u> of <u>McNeil</u> (distance) (direction) (nearest town)	<u>Fine Sand</u>	<u>90</u>	<u>95</u>
WELL PURPOSE: <u>Home</u> (home, irrigation, municipal, industrial)	<u>Blue Shale</u>	<u>95</u>	<u>135</u>
WELL COMPLETION DATA: (1) diameter (inches) <u>2</u>	<u>Fine Sand</u>	<u>135</u>	<u>141</u>
(2) total depth (feet) <u>241</u>	<u>Blue Shale</u>	<u>141</u>	<u>217</u>
(3) static water level (feet) <u>39</u> below top of ground. above	<u>Coarse Sand</u>	<u>217</u>	<u>241</u>
(4) casing <u>PVC</u> , <u>231</u> (material), (depth) (size) If telescope see back.			
(5) screen <u>10</u> , <u>231</u> (length), (depth to top) <u>10</u> <u>PVC</u> (size), (material)			
(6) pump <u>1/2</u> , <u>6</u> (HP), (yield gpm)			
<u>Electric</u> (type power)			
(7) electric log <u>no</u> (yes or no)			
(organization running log)			
(8) how well bottom plugged <u>Sand Shark</u>			
DRILLERS REMARKS:			


DEPT. OF NATURAL RESOURCES
 BUREAU OF LAND & WATER RESOURCES

AUG 8 1983

RECEIVED

If well telescopes please sketch and show depths.

GROUND LEVEL

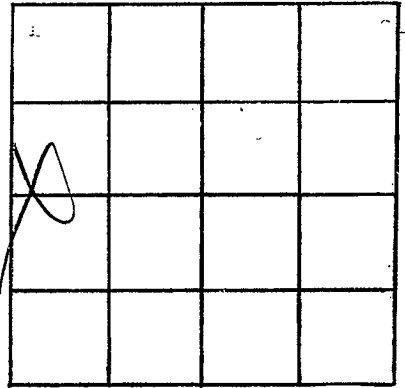

SECTION _____

Please indicate well location X.

ADDITIONAL INFORMATION

If more than one screen,
show locations of each on sketch.