

MISSISSIPPI DEPARTMENT OF NATURAL RESOURCES

Bureau of Land and Water Resources

Southport Mall

P.O. Box 10631

Jackson, Mississippi 39209

WATER WELL DRILLERS LOG

POUNCEY WATER WELL DRILLING

Pearl River
R
0003

Pearl River.

7-22 1983
date well completed

firm name

county well located

LANDOWNER: Aug Smith
Poplarville Rt.
1/2 mile N Gibson Stn.
(mailing address)

description of formations encountered

from to

WELL LOCATION:
sec. 14 T. 4 N. R. 15 E. CS W
2 1/2 miles S of SAVANNA
(distance) (direction) (nearest town)

Top.	0	14
sd.	14	41
clay gravel	41	46
sd.	46	66

WELL PURPOSE:
(home, irrigation, municipal, industrial)

WELL COMPLETION DATA:

- (1) diameter (inches) 2
- (2) total depth (feet) 64
- (3) static water level (feet) 42 below top of ground.
- (4) casing PVC 56 (material) (depth)
2 (size) If telescope see back.
- (5) screen 10 56 (length) (depth to top)
2 PVC (size) (material)
- (6) pump 1 8 (HP) (yield gpm)
Ac- (type power)
- (7) electric log (yes or no)
 (organization running log)
- (8) how well bottom plugged Sealed

DEPT. OF NATURAL RESOURCES
BUREAU OF LAND & WATER RESOURCES


AUG 26 1983

RECEIVED

DRILLERS REMARKS: Last 12'
good sd.

If well telescopes please sketch and show depths.

GROUND LEVEL

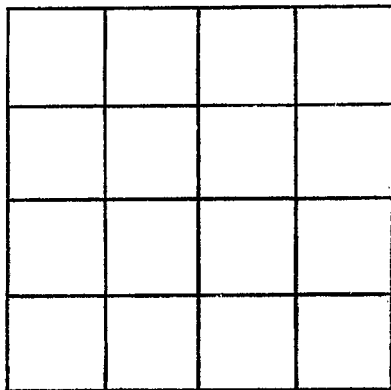

SECTION _____

Please indicate well location X.

ADDITIONAL INFORMATION

If more than one screen, show locations of each on sketch.