

MISSISSIPPI DEPARTMENT OF NATURAL RESOURCES

Bureau of Land and Water Resources

Southport Mall

P.O. Box 10631

Jackson, Mississippi 39209

WATER WELL DRILLERS LOG

Pearl River  
R 1  
2024

Nov 28-83 19 Walkers Welding Pearl River  
 date well completed firm name county well located

LANDOWNER: Tom Hughes  
59 Waver Circle  
New Orleans La  
 (mailing address)

description of formations encountered	from	to
<u>Red shale</u>	<u>0</u>	<u>20</u>
<u>white shale</u>	<u>20</u>	<u>48</u>
<u>sand first gravel</u>	<u>48</u>	<u>65</u>

WELL LOCATION:  
 sec. 13 T 4 N R 15 W  
12 miles South Poplarville  
 (distance) (direction) (nearest town)

WELL PURPOSE:  
 (home, irrigation, municipal, industrial)

- WELL COMPLETION DATA:
- (1) diameter (inches) 4"
  - (2) total depth (feet) 65
  - (3) static water level (feet) 50 below top of ground.
  - (4) casing PVC 55'  
 (material) (depth)  
 (size) if telescope see back.
  - (5) screen 10' 55'  
 (length) (depth to top)  
12 (size) PVC (material)
  - (6) pump 1/2 10  
 (HP) (yield gpm)  
Elec (type power)
  - (7) electric log (yes or no)
  - (organization running log)
  - (8) how well bottom plugged sand  
shale

DEPT. OF NATURAL RESOURCES  
 BUREAU OF LAND & WATER RESOURCES


DEC 29 1983

DRILLERS REMARKS:

RECEIVED

If well telescopes please sketch and show depths.

GROUND LEVEL

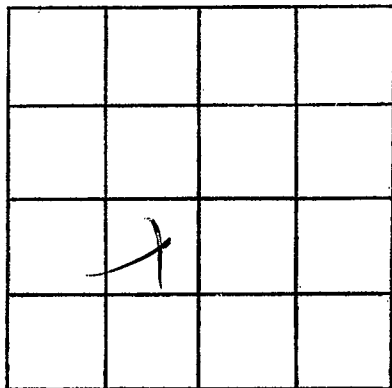

SECTION \_\_\_\_\_

Please indicate well location X.

ADDITIONAL INFORMATION

If more than one screen,  
show locations of each on sketch.