

MISSISSIPPI DEPARTMENT OF NATURAL RESOURCES

Bureau of Land and Water Resources

Southport Mall

P.O. Box 10631

Jackson, Mississippi 39209

WATER WELL DRILLERS LOG

*Pearl River*  
R  
2005

**POUNCEY WATER WELL DRILLING** *Pearl River*

11-29-83  
 date well completed

firm name

county well located


LANDOWNER: <i>Benny Cline</i>	description of formations encountered	from	to
<i>Hwy 53 S Pouncey</i>	<i>Top</i>	<i>0</i>	<i>10</i>
(mailing address)	<i>Soft clay joint</i>	<i>10</i>	<i>26</i>
WELL LOCATION:	<i>SD junky</i>	<i>26</i>	<i>40</i>
sec. <u>14</u> T <u>4</u> N R <u>15</u> E	<i>SD to ground</i>	<i>40</i>	<i>65</i>
CS CS W			
<u>3</u> miles <u>S</u> of <u>SAVANNA</u>			
(distance) (direction) (nearest town)			
WELL PURPOSE: <i>Home</i>			
(home, irrigation, municipal, industrial)			
WELL COMPLETION DATA:			
(1) diameter (inches) <u>2</u>			
(2) total depth (feet) <u>65</u>			
(3) static water level (feet) <u>48</u> below top of ground.			
(4) casing <u>PVC</u> , <u>55</u>			
(material) (depth)			
<u>2</u> if telescope see back.			
(size)			
(5) screen <u>10</u> , <u>55</u>			
(length) (depth to top)			
<u>2</u> , <u>PVC</u>			
(size) (material)			
(6) pump <u>1</u> , <u>10</u>			
(HP) (yield gpm)			
<u>PC</u>			
(type power)			
(7) electric log <u>no</u>			
(yes or no)			
(organization running log)			
(8) how well bottom plugged <i>Sealed</i>			

DRILLERS REMARKS: *58' - 65' less gravel good brown fine to med sd.*

DEPT. OF NATURAL RESOURCES  
 BUREAU OF LAND & WATER RESOURCES  
 RECEIVED  
 JAN 26 1984

If well telescopes please sketch and show depths.

GROUND LEVEL

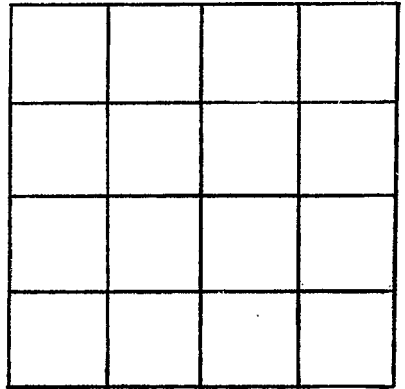

SECTION \_\_\_\_\_

Please indicate well location X.

ADDITIONAL INFORMATION

If more than one screen, show locations of each on sketch.