

MISSISSIPPI DEPARTMENT OF NATURAL RESOURCES

Bureau of Land and Water Resources

Southport Mall

P.O. Box 10631

Jackson, Mississippi 39209

WATER WELL DRILLERS LOG

Pool River
R0027

BOUNCY WATER WELL DRILLING

Pool River

11-20 1983
date well completed

firm name

county well located

LANDOWNER: <u>David Cronetto</u>	description of formations encountered	from	to
<u>Ny 53 SAVANT.</u>	<u>Top.</u>	<u>0</u>	<u>8</u>
(mailing address)	<u>Sdy Clay junk</u>	<u>8</u>	<u>25</u>
WELL LOCATION: sec. <u>14</u> T. <u>4</u> N R. <u>15</u> E CS CW	<u>Clay junk</u>	<u>25</u>	<u>28</u>
<u>3</u> miles <u>S</u> of <u>SAVANA.</u> (distance) (direction) (nearest town)	<u>sd - Big some junk</u>	<u>28</u>	<u>39</u>
WELL PURPOSE: <u>Home</u> (home, irrigation, municipal, industrial)	<u>sd to gravel</u>	<u>39</u>	<u>65</u>
WELL COMPLETION DATA:			
(1) diameter (inches) <u>2</u>			
(2) total depth (feet) <u>65</u>			
(3) static water level (feet) <u>52</u> below top of ground.			
(4) casing <u>PVC 57</u> (material) (depth)			
<u>2</u> if telescope see back. (size)			
(5) screen <u>7 57</u> (length) (depth to top)			
<u>2</u> PVC (size) (material)			
(6) pump <u>1 8</u> (HP) (yield gpm)			
<u>pc</u> (type power)			
(7) electric log <u>NO</u> (yes or no)			
(organization running log)			
(8) how well bottom plugged <u>Sealed</u>			


DRILLERS REMARKS:
50' to 65' Better sd gravel.

DEPT. OF NATURAL RESOURCES
BUREAU OF LAND & WATER RESOURCES

JAN 26 1984
RECEIVED

If well telescopes please sketch and show depths.

GROUND LEVEL

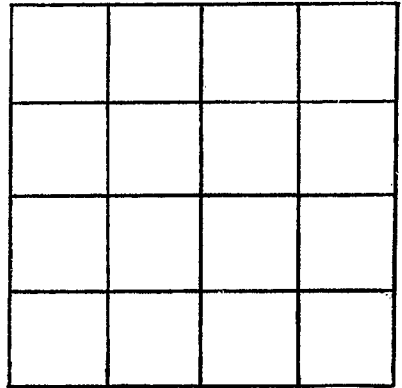

SECTION _____

Please indicate well location X.

ADDITIONAL INFORMATION

If more than one screen, show locations of each on sketch.