

MISSISSIPPI DEPARTMENT OF NATURAL RESOURCES
 Bureau of Land and Water Resources
 Southport Mall
 P.O. Box 10631
 Jackson, Mississippi 39209
WATER WELL DRILLERS LOG

PEARL RIVER
 R20007

6/26 1984 Bud Penton Water Well Pearl River
 date well completed firm name county well located

LANDOWNER: Wolliet Smith
RT 4 Box 156 Poplarville
Miss.
 (mailing address)

WELL LOCATION:
 sec. 7 T 4 N R 15 E
 S W
8 miles E of Turrell
 (distance) (direction) (nearest town)

WELL PURPOSE: home
 (home, irrigation, municipal, industrial)

WELL COMPLETION DATA:

- (1) diameter (inches) 2"
- (2) total depth (feet) 622
- (3) static water level (feet) 80 below above top of ground.
- (4) casing pvc 6 1/2" (material), (depth)
- _____ if telescope see back. (size)
- (5) screen 2x10, 6 1/2" (length), (depth to top)
10, pvc (size), (material)
- (6) pump NO (HP), (yield gpm)
 (type power)
- (7) electric log NO (yes or no)
 (organization running log)

(8) how well bottom plugged plugged

DRILLERS REMARKS:

description of formations encountered	from	to
Red shale	0	29
Red sand	2	60
White shale	60	150
White sand	150	210
Blue shale	210	312
Blue sand	312	466
Blue shale	466	570
Gray sand	570	622


DEPT. OF NATURAL RESOURCES
 BUREAU OF LAND & WATER RESOURCES

JUL 19 1984

RECEIVED

If well telescopes please sketch and show depths.

GROUND LEVEL

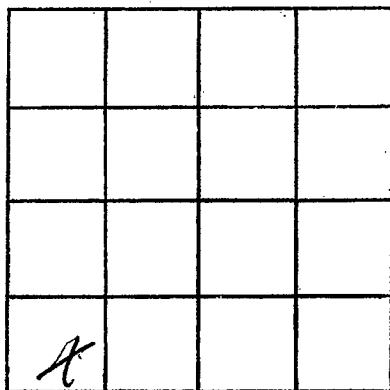

SECTION _____

Please indicate well location X.

ADDITIONAL INFORMATION

If more than one screen, show locations of each on sketch.