

MISSISSIPPI DEPARTMENT OF NATURAL RESOURCES

Bureau of Land and Water Resources

Southport Mall

P.O. Box 10631

Jackson, Mississippi 39209

WATER WELL DRILLERS LOG

Pearl River  
R  
2030

Pearl River

10-12-84 1984 POUNCEY WATER WELL DRILLING firm name Pearl River county well located

LANDOWNER: Sal Pappalardo -  
St. Savana -  
(mailing address)

description of formations encountered	from	to
top	0	18
SD & gravel	18	48
Clay gravel	48	76
Clay shale	76	304
SD -	304	370

WELL LOCATION:  
sec. 13 T 4 N R 15 E  
1 1/2 miles E of SW Hollow  
(distance) (direction) (nearest town)

WELL PURPOSE: Home  
(home, irrigation, municipal, industrial)

- WELL COMPLETION DATA:
- (1) diameter (inches) 4
  - (2) total depth (feet) 370
  - (3) static water level (feet) 130 below top of ground
  - (4) casing Pvc 355  
(material) (depth)  
4 if telescope see back.  
(size)
  - (5) screen 15 355  
(length) (depth to top)  
4 Pvc  
(size) (material)
  - (6) pump 1 30  
(HP) (yield gpm)  
AC  
(type power)
  - (7) electric log \_\_\_\_\_  
(yes or no)  
\_\_\_\_\_  
(organization running log)
  - (8) how well bottom plugged \_\_\_\_\_


RECEIVED  
FEB 25 1985

DRILLERS REMARKS:

Department of Natural Resources  
Bureau of Land & Water Resources

If well telescopes please sketch and show depths.

GROUND LEVEL

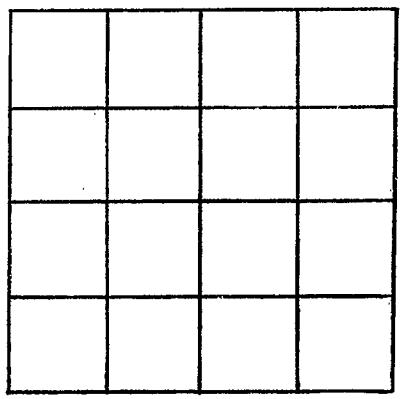

SECTION \_\_\_\_\_

Please indicate well location X.

ADDITIONAL INFORMATION

A series of horizontal lines for entering additional information.

If more than one screen, show locations of each on sketch.