

MISSISSIPPI DEPARTMENT OF NATURAL RESOURCES

Bureau of Land and Water Resources

Southport Mall

P.O. Box 10631

Jackson, Mississippi 39209

WATER WELL DRILLERS LOG

Pearl River
R 88 2032
9-27-85

9/27 1985 PENTON & SON
 date well completed firm name

Pearl River
~~Mississippi~~
 county well located

LANDOWNER: J. S. CON
R.T. 2 Box 449 CARRIERE
MISS 39426
 (mailing address)

| description of formations encountered | from | to |
|---------------------------------------|------------|------------|
| <u>Red shale</u> | <u>0</u> | <u>160</u> |
| <u>Red sand</u> | <u>160</u> | <u>170</u> |
| <u>Blue shale</u> | <u>120</u> | <u>298</u> |
| <u>Blue sand</u> | <u>290</u> | <u>390</u> |
| <u>Blue shale</u> | <u>370</u> | <u>440</u> |
| <u>Gray sand</u> | <u>440</u> | <u>490</u> |

WELL LOCATION:
 sec. 20 T. 4 N. R. 15 E.
15 miles E of Carriere
 (distance) (direction) (nearest town)

WELL PURPOSE: Home
 (home, irrigation, municipal, industrial)

- WELL COMPLETION DATA:
- (1) diameter (inches) 4
 - (2) total depth (feet) 491
 - (3) static water level (feet) 102 below above top of ground.
 - (4) casing PCU 491
 (material) (depth)
20 if telescope see back.
 (size)
 - (5) screen 4x20 471
 (length) (depth to top)
12 PCU
 (size) (material)
 - (6) pump 1 1/2 1350
 (HP) (yield gpm)
Elect
 (type power)
 - (7) electric log no
 (yes or no)
 (organization running log)
 - (8) how well bottom plugged good


DRILLERS REMARKS:
fresh

RECEIVED
 NOV 2 6 1985

Department of Natural Resources
 Bureau of Land & Water Resources

If well telescopes please sketch and show depths.

GROUND LEVEL

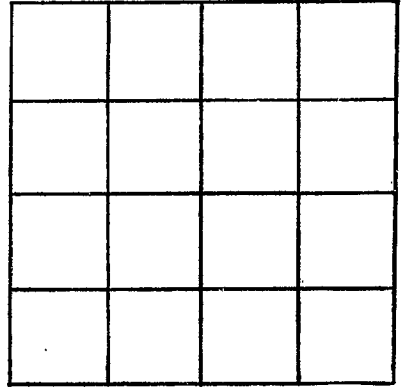

SECTION _____

Please indicate well location X.

ADDITIONAL INFORMATION

If more than one screen, show locations of each on sketch.