

PEARL RIVER  
R0034

MISSISSIPPI DEPARTMENT OF NATURAL RESOURCES  
Bureau of Land and Water Resources  
Southport Mall  
P.O. Box 10631

Jackson, Mississippi 39209  
WATER WELL DRILLERS LOG

POUNCEY WATER WELL DRILLING

Pearl River  
county well located

6-20 1986  
date well completed

firm name

LANDOWNER: Paul Kirkland

description of formations encountered

from to

Enochalla, Gibson Rd

(mailing address)

WELL LOCATION:

sec 10 T 4 N R 15 E  
S W  
1 1/2 miles S of Savannah  
(distance) (direction) (nearest town)

WELL PURPOSE: Home  
(home, irrigation, municipal, industrial)

WELL COMPLETION DATA:

- (1) diameter (inches) 2
- (2) total depth (feet) 48
- (3) static water level (feet) 32 below top of ground
- (4) casing IR 43  
(material) (depth)  
2 if telescope see back.  
(size)
- (5) screen 5 43  
(length) (depth to top)  
2 PVC  
(size) (material)
- (6) pump 1 1/2 4  
(HP) (yield gpm)  
AC  
(type power)
- (7) electric log (yes or no)

(organization running log)

(8) how well bottom plugged Sealed

top  
SD ground 10 42  
gravel 42 48


RECEIVED  
JUL 01 1986

Department of Natural Resources  
Bureau of Land & Water Resources

DRILLERS REMARKS:

If well telescopes please  
sketch and show depths.

GROUND LEVEL

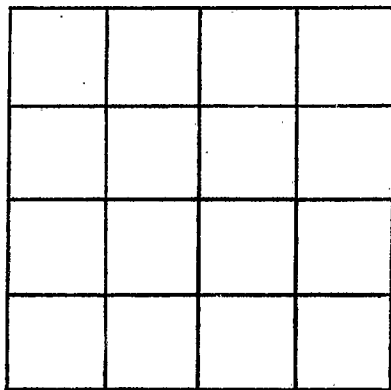

SECTION \_\_\_\_\_

Please indicate well location X.

ADDITIONAL INFORMATION

If more than one screen,  
show locations of each on sketch.