

MISSISSIPPI DEPARTMENT OF NATURAL RESOURCES

Bureau of Land and Water Resources

Southport Mall

P.O. Box 10631

Jackson, Mississippi 39209

WATER WELL DRILLERS LOG

Pear River  
R 2030

2/23 1988 Red Penton Pear River  
date well completed firm name county well located


LANDOWNER: <u>Ronald</u> <u>Gaubert 314</u>	description of formations encountered	from	to
<u>Jumbles Lane</u> (mailing address)			
	<u>Red sand</u>	<u>60</u>	<u>95</u>
	<u>Blue shale</u>	<u>95</u>	<u>400</u>
	<u>Gravel sand</u>	<u>400</u>	<u>446</u>

WELL LOCATION:  
sec. 10 T. 4 N R. 15 E  
S W  
6 miles East of Carroll  
(distance) (direction) (nearest town)

WELL PURPOSE: Home  
(home, irrigation, municipal, industrial)

- WELL COMPLETION DATA:
- (1) diameter (inches) 4x2"
  - (2) total depth (feet) 446
  - (3) static water level (feet) 95 below above top of ground.
  - (4) casing PVC 446  
(material) (depth)  
4x2" if telescope see back.  
(size)
  - (5) screen 10 436  
(length) (depth to top)  
12 PVC  
(size) (material)
  - (6) pump 1 18  
(HP) (yield gpm)  
Elect  
(type power)
  - (7) electric log no  
(yes or no)
- (organization running log)
- (8) how well bottom plugged Sand  
Sharp

DRILLERS REMARKS:

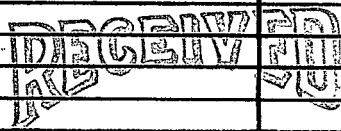


APR 29 1988

Department of Natural Resources  
Bureau of Land & Water Resources

If well telescopes please sketch and show depths.

GROUND LEVEL

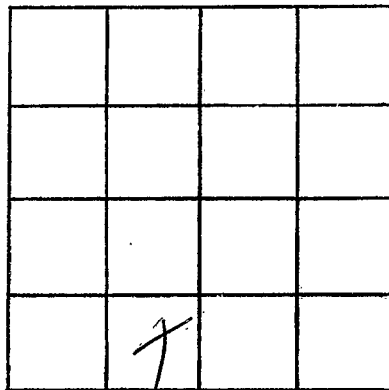

SECTION \_\_\_\_\_

Please indicate well location X.

ADDITIONAL INFORMATION

If more than one screen, show locations of each on sketch.