

MISSISSIPPI DEPARTMENT OF NATURAL RESOURCES
 Bureau of Land and Water Resources
 Southport Mall
 P.O. Box 10631
 Jackson, Mississippi 39209
WATER WELL DRILLERS LOG

P. RIVER
R 2041

11-6 date well completed 1990 Bud Denton firm name Pearl River county well located

LANDOWNER: Donny Wain
R.T. 5 Poplarville
MISS
 (mailing address)


WELL LOCATION:
 sec. 6 T. 4 N. R. 15 E
4 miles NE of McNeil
 (distance) (direction) (nearest town)

WELL PURPOSE: home
 (home, irrigation, municipal, industrial)

WELL COMPLETION DATA:

- (1) diameter (inches) 4
- (2) total depth (feet) 1092
- (3) static water level (feet) 149 below/above top of ground.
- (4) casing pvc material, 1092 (depth)
4x2 (size) if telescope see back.
- (5) screen 15 (length), 1077 (depth to top)
8 (size), pvc (material)
- (6) pump 1 (HP), 15 (yield gpm)
Elect (type power)
- (7) electric log no (yes or no)
 (organization running log)
- (8) how well bottom plugged Sand

description of formations encountered	from	to
<u>white shell</u>	<u>0</u>	<u>10</u>
<u>white sand</u>	<u>10</u>	<u>70</u>
<u>Blue shale</u>	<u>70</u>	<u>200</u>
<u>white sand</u>	<u>200</u>	<u>372</u>
<u>Blue shale</u>	<u>372</u>	<u>910</u>
<u>Blue sand no gravel</u>	<u>910</u>	<u>960</u>
<u>Blue shale</u>	<u>960</u>	<u>970</u>
<u>Grey sand</u>	<u>970</u>	<u>1092</u>

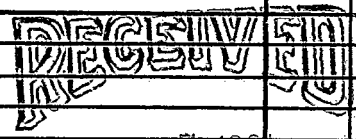

JUN 7 1991

Dept. of Environmental Quality
 Bureau of Land & Water Resources


DRILLERS REMARKS:

If well telescopes please sketch and show depths.

GROUND LEVEL

872 - 2" | 22 off X 4"

If more than one screen, show locations of each on sketch.

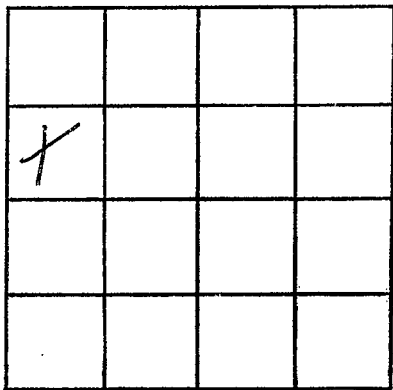

SECTION _____

Please indicate well location X.

ADDITIONAL INFORMATION

Horizontal lines for additional information.