

MISSISSIPPI DEPARTMENT OF NATURAL RESOURCES

Bureau of Land and Water Resources

Southport Mall

P.O. Box 10631

Jackson, Mississippi 39209

WATER WELL DRILLERS LOG

P. RIVER
R 2044

11-6-1992 Bud Penton Water Well Pearl River
 date well completed firm name county well located

LANDOWNER: Charles Heck
 Rt 4 Box 156 Poplarville
 Mc 39470
 (mailing address)

WELL LOCATION:
 sec. 7 T 4 N R 15 E
 S W
 3.2 miles E of Millard
 (distance) (direction) (nearest town)

WELL PURPOSE: Home
 (home, irrigation, municipal, industrial)


WELL COMPLETION DATA:

- (1) diameter (inches) 7
- (2) total depth (feet) 1010
- (3) static water level (feet) 99 below above top of ground.
- (4) casing PVC 990
 (material) (depth)
 4" x 2" if telescope see back.
 (size)
- (5) screen 20 990
 (length) (depth to top)
 2 PVC
 (size) (material)
- (6) pump 1 18
 (HP) (yield gpm)
 electric
 (type power)
- (7) electric log NO
 (yes or no)

(organization running log)

- (8) how well bottom plugged sandshank

description of formations encountered	from	to
white clay	0	35
blue sand	35	305
blue clay	305	378
blue sand	378	400
blue clay	400	819
GRAY SAND	819	875
blue clay	875	950
GRAY SAND	950	1010

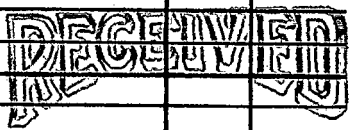

DEC 10 1992

Dept. of Environmental Quality
 Bureau of Land & Water Resources

DRILLERS REMARKS:

If well telescopes please sketch and show depths.

GROUND LEVEL

200' 4"

810' 2"

ℓ			

SECTION 2

Please indicate well location X.

ADDITIONAL INFORMATION

If more than one screen, show locations of each on sketch.