

MISSISSIPPI DEPARTMENT OF ENVIRONMENTAL QUALITY
Office of Land and Water Resources

P. O. Box 10631
Jackson, MS 39289-0631
WATER WELL DRILLERS LOG

COUNTY WELL LOCATED <i>Pearl River</i>	
WELL NUMBER <i>R-2052</i>	CODED
DATE WELL COMPLETED <i>5-9-01</i>	

PERMIT NUMBER
NAME OF DRILLING FIRM <i>Boonewater Well</i>

NAME & MAILING ADDRESS OF LANDOWNER <i>Jerry Bond</i>			
<i>83 Red Fish Rd</i>			
<i>Poplarville, Ms 39470</i>			
WELL LOCATION: SEC	TOWNSHIP	RANGE	
<i>2</i>	<i>4</i>	<i>N 15 E</i>	
DISTANCE	DIRECTION	NEAREST TOWN	
<i>5</i> Miles	<i>S</i>	<i>Poplarville</i>	
OTHER LANDMARK			
WELL PURPOSE <input checked="" type="radio"/> Home Irrigation, Municipal, Industrial, Fish Pond, etc.			

PUMP DATA		
PUMP TYPE (Circle One): <input checked="" type="radio"/> Submersible, Turbine, Jet, Flowing Well, Other (Describe) _____		
POWER TYPE (Circle One): <input checked="" type="radio"/> Electric, Tractor, Diesel, Gasoline, Butane, Other (Describe) _____ H/P <i>1</i>		
Pump Capacity (GPM) <i>20</i>	No. of Stages	Setting Depth _____ FT.
PUMP TEST		
Well yielded _____ GPM with a drawdown of _____ ft. after _____ hours of pumping		

WELL DATA		
Well Depth <i>140</i>	Casing Diameter (In.) <i>4</i>	Casing Length (Ft.) <i>120</i>
Type of Casing <i>SCW40</i>	Hole Depth <i>140</i>	Depth to Static Water Level <i>60</i>
TYPE OF COMPLETION: (Circle One or More): <input checked="" type="radio"/> Gravel Packed, Underreamed, Telescoped, Natural Development, Open Hole, Other (Describe) _____		

LOG DATA	
TYPE OF LOG RUN (Circle One): <input type="radio"/> No Log Run, Electric, Gamma Ray, Density, Sonic, Neutron, Other (Describe) _____	
Name of Organization Running Log	

WELL GROUTED TO A DEPTH OF <i>10</i> FEET Type Grout (circle one): <input checked="" type="radio"/> Cement, Bentonite, or Mix
--

GEOLOGIC DATA (Office Use Only)			
Surface Elev.	Geologic Unit	Unit Thickness	Depth to Top
Subs. SWL	Date	Analysis	Aquifer Test
Driller's Remarks			
Top of Lap Pipe or Reduction in Casing			
FEET		IF TELESCOPED OR MORE THAN ONE SCREEN: USE BACK PAGE	


SCREEN DATA		
Diameter - Inches <i>4</i>	Length - Feet <i>20</i>	Slot Size - Inches <i>#8</i>
Screen Type <i>sch 40</i>	Depth to Bottom - Feet	

DESCRIPTION OF FORMATIONS ENCOUNTERED	FROM	TO
<i>Clay</i>	<i>0</i>	<i>60</i>
<i>Sand</i>	<i>60</i>	<i>140</i>

FORMATIONS (Continued)	FROM	TO
REC'D AUG 24 2001		

If well telescopes please
sketch and show depths.

GROUND LEVEL

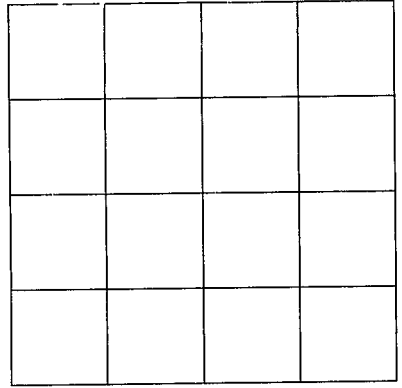

SECTION _____

Please indicate well location X.

ADDITIONAL INFORMATION

If more than one screen,
show location of each on sketch.